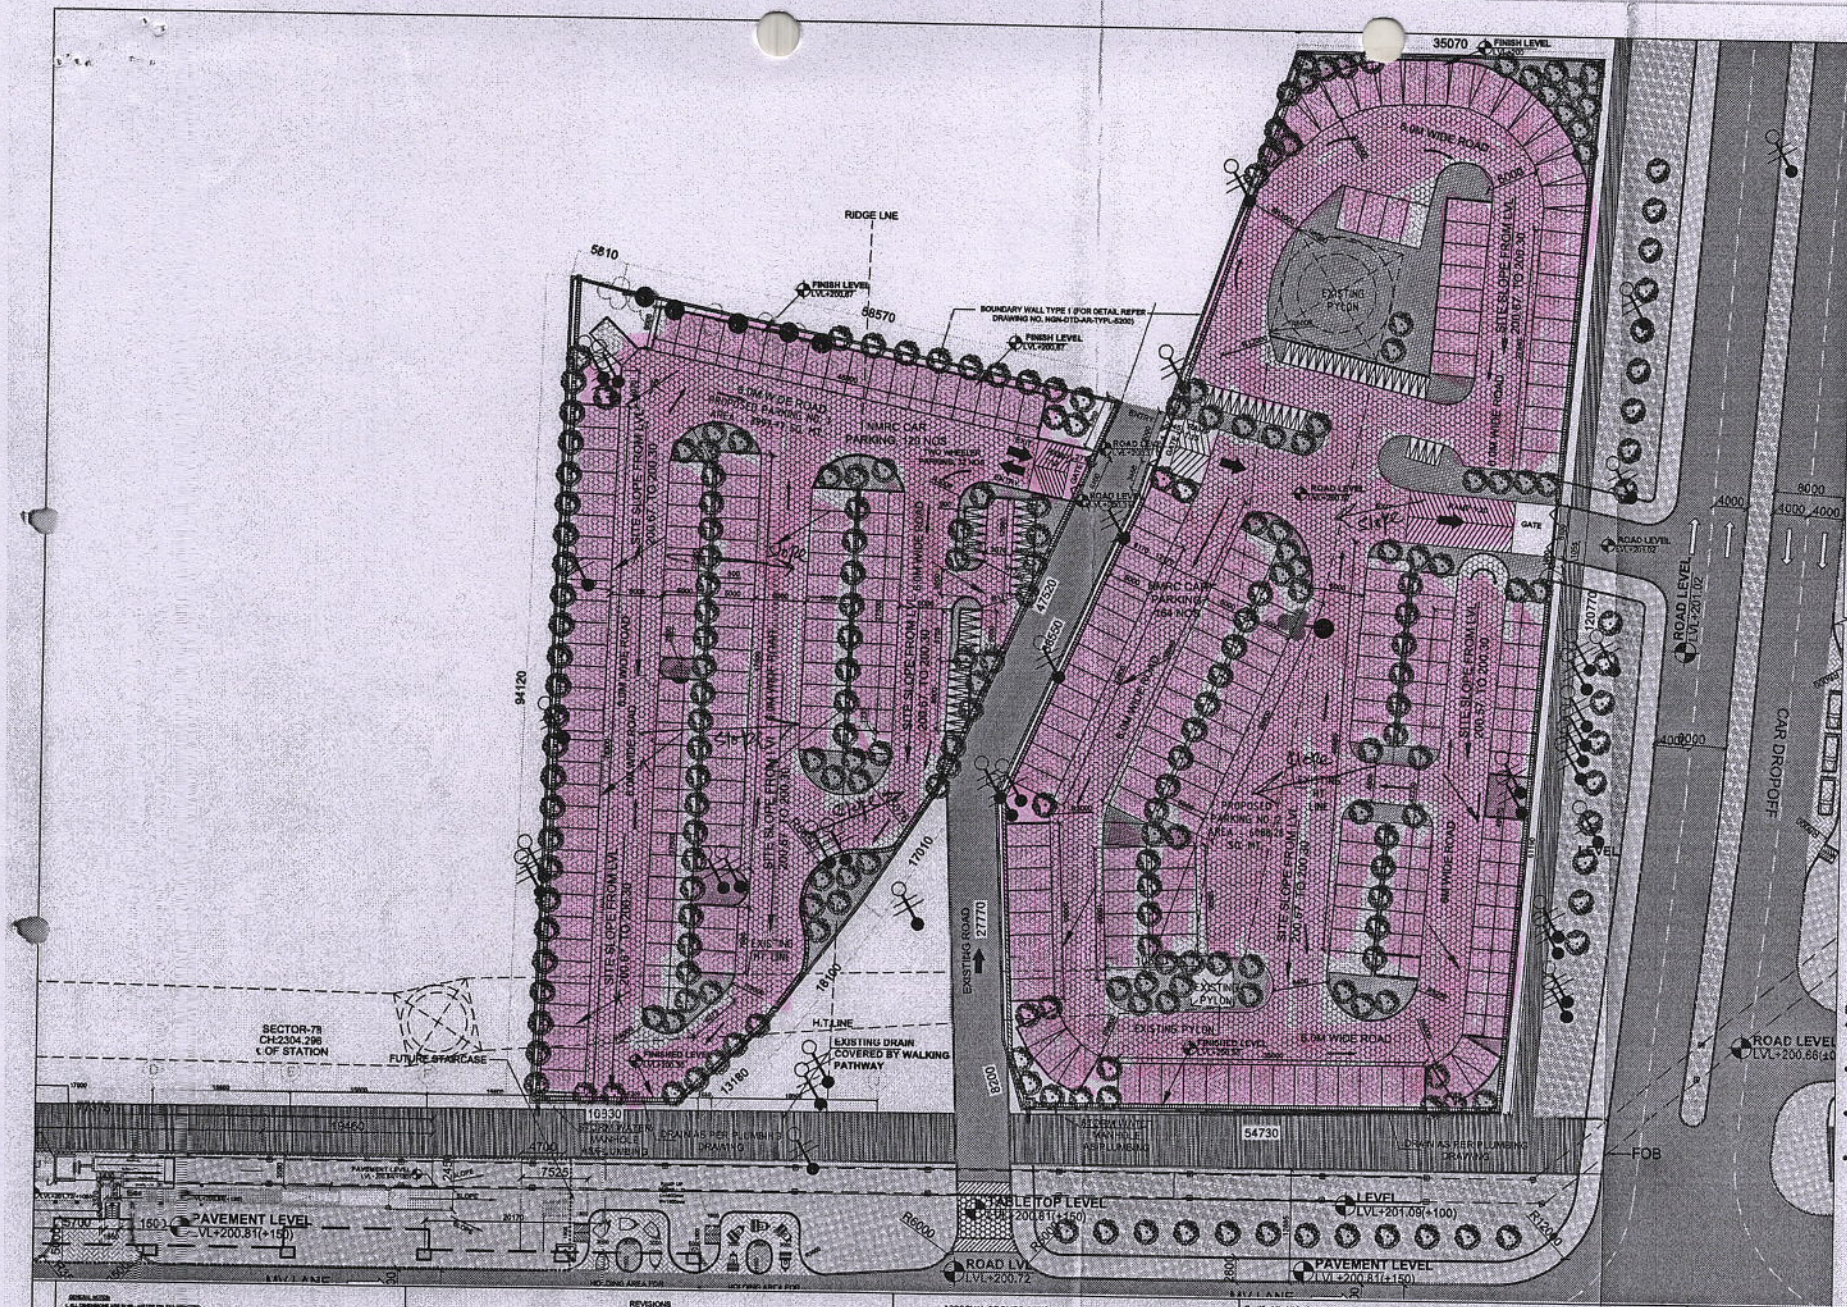

NOTES:

- FOR BOUNDARY WALL DETAIL REFER DRAWING NO. NGN-DTD-AR-TYPL-5200 (TYPE 1)
- FOR GATE DETAIL REFER DRAWING NO. NGN-DTD-AR-TYPL-5201
- FOR TYPICAL PARKING DETAIL REFER DRAWING NO. NGN-DTD-AR-TYPL-5210
- DRAIN LOCATIONS ARE TENTATIVE, FOR DETAIL REFER PLUMBING DRAWINGS.

NMRC PARKING DETAIL:

NO OF PARKING:- 286

- FOUR WHEELER: ~~286~~ NOS
- TWO WHEELER : ~~140~~ NOS 62

REVISIONS

REV.	DESCRIPTION	DATE	DRAWN BY	CHECKED BY
R2	STATION PARKING LEVELS ARE REVISED AS PER THE LATEST LEVELS RECEIVED ON 8-3-2018 BY DMRC.	23.03.2018	MANISHA	S. MITTAL
R1	AS PER SITE LEVELS, CONDITIONS & DECISION OF REVIEW MEETING HELD ON 23-01-2018	25.01.2018	MANISHA	S. MITTAL
R0	AS PER THE APPROVED EXTERNAL DEVELOPMENT DRAWING NO: NGN-DTD-AR-03S078-5001	03.01.2018	A. MOHAN	S. MITTAL

APPROVAL OF DMRC OFFICIALS

RA	Dy CA/Arch	CA	AM/Tele	Sr. DGM/Tele	ED/S&T/P-I	
AM/Elect	DGM/Elec.	CEE	AM/Mtg	DGM/S&T-II	ED/S&T/P-II	
AM/AFC	Dy CETS/AFC	MNGR/FIRE	CRE	PGM-GN		

Certified that this document has been designed and checked in accordance with DDC Quality Assurance Plan.

Authorised Signatory for DDC NCDD01 Project Manager

Architecture: Design In-charge/ Coordinator | Structure: Design In-charge/ Coordinator | EAM: Design In-charge/ Coordinator

DETAIL DESIGN CONSULTANT :

ayesa — Engineering. Information. Imagination.

56, Indo-Asia House, Institutional Area, sector-44 Gurgaon - 122002 (Haryana)

DELHI METRO RAIL CORPORATION LTD.

Metro Bhawan, Fire Brigade Lane, Barakhamba Road, New Delhi-110001

PROJECT: NOIDA - GREATER NOIDA CORRIDOR

STATION: SECTOR 78

DRAWING TITLE: STATION PARKING LAYOUT

DRAWN BY:	CHECKED BY:	VERIFIED BY:	APPROVED BY:
ADN	SHF	SHF	PMD
DATE: 27.12.2017	REV: R-2	SCALE: 1:400	STATUS: GFC
DRAWING NUMBER: NGN-DTD-AR-03S078-5301		SHEET NO.	SHEET SIZE: A-2

DDC - NCDD01

This drawing must not be either loaned, copied or otherwise reproduced in whole or in part or used for any purpose without the prior written permission of DMRC.

183

Sec-76

14

154

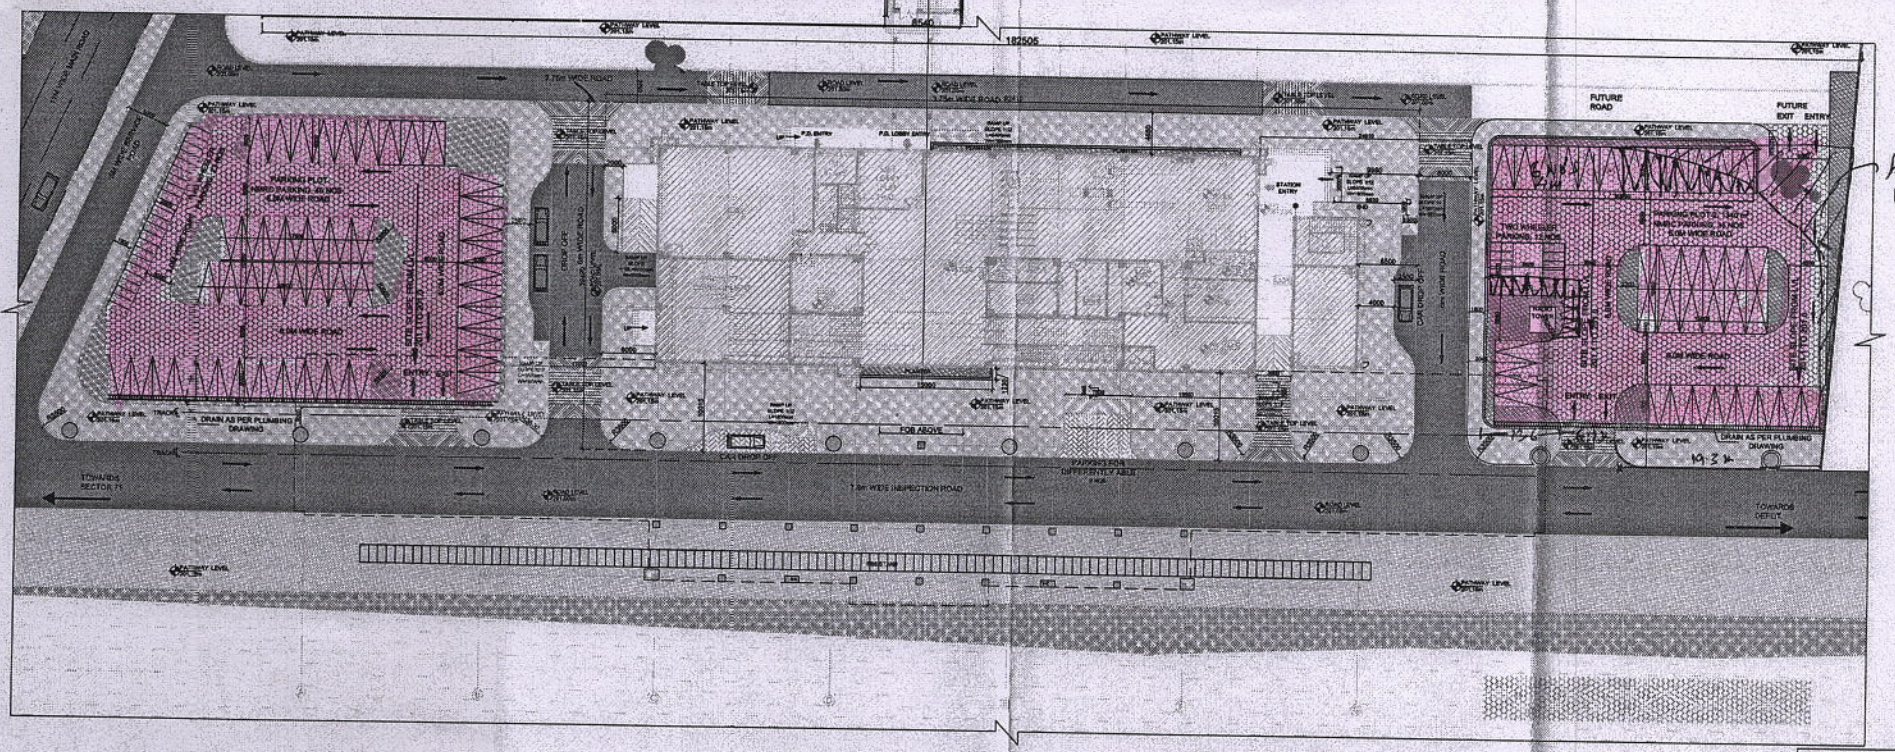

NMRC PARKING DETAIL:

NO OF PARKING PLOT-1:-

- FOUR WHEELER:46 NOS
- TWO WHEELER : 23 NOS

NO OF PARKING PLOT-2:-

- FOUR WHEELER:35 NOS
- TWO WHEELER : ~~12 NOS~~ 23

NOTES:

- FOR BOUNDARY WALL DETAIL REFER DRAWING NO. NGN-DTD-AR-TYPL-5200 (TYPE 1)
- FOR GATE DETAIL REFER DRAWING NO. NGN-DTD-AR-TYPL-5201
- FOR TYPICAL PARKING DETAIL REFER DRAWING NO. NGN-DTD-AR-TYPL-5210
- CATCH BASIN AND MAN HOLE LOCATIONS ARE TENTATIVE, FOR DETAIL REFER PLUMBING DRAWINGS.

LEGEND

- LOAD BEARING PAVER BLOCKS (LIGHT)
- LOAD BEARING PAVER BLOCKS (DARK)
- PAVER BLOCKS (LIGHT)
- ROAD
- SHRUBS
- MAINTAINED GREEN
- WILD GREEN
- CYCLE TRACK
- DROP OFF AREA (CONCRETE)
- PAVER BLOCKS (DARK)
- EXISTING ELECTRICAL POLES
- EXISTING TREES
- TREES TO BE CUT/RELOCATED
- PROPOSED TREES
- LAND PLAN
- AREA OF EXTENT OF EXTERNAL DEVELOPMENT

GENERAL NOTES:
1. ALL DIMENSIONS ARE IN MILLIMETER UNLESS NO TEDNOR.
2. ALL DIMENSIONS ARE TO BE READ AND NOT MEASURED.
3. ANY DISCREPANCY MUST BE BROUGHT TO THE NOTICE OF THE DMRC BEFORE INSCRIPTION OF WORK AT SITE.
4. THIS DRAWING MUST BE READ IN CONJUNCTION WITH ALL RELEVANT ARCHITECTURAL, STRUCTURAL, PLUMBING & FIRE FIGHTING, FLOTIONAL AND TRAFFIC MANAGEMENT DRAWINGS.
5. ALL DIMENSIONS OLL & LATITUDE LEVELS ARE MEASURED FROM MAN HOLLOW FINISH LEVELS.

THIS DRAWING IS THE PROPERTY OF DELHI METRO RAIL CORPORATION LTD.

REFERENCE DRAWINGS

REVISION	DESCRIPTION	DRAWING NO.

REVISIONS

REV.	DESCRIPTION	DATE	DRAWN BY	CHECKED, BY
R2	PARKING LAYOUT REVISED, AS PER THE NEW PARKING PLOT OF TWO NUMBERS RECEIVED ON 13-04-2018.	17.04.2018	MANIS-IA	S. MITTAL
R1	AS PER SITE LEVELS, SITE CONDITIONS & DECISIONS OF REVIEW MEETING HELD ON 23-01-2018	25.01.2018	MANIS-IA	S. MITTAL
R0	AS PER THE APPROVED EXTERNAL DEVELOPMENT DRAWING NO: NGN-DTD-AR-045101-5001	03.01.2018	A. KHAN	S. MITTAL

APPROVAL OF DMRC OFFICIALS

RA	Dy CA/Arch.	CA	AM/Tele	Sr. DGM/Tele	EDI/S&T/P-J	
AM/ Elect	DGM/Elec.	CEE	AM/Hv	JGM/S&T-II	EDI/S&T/P-II	
AM/ APC	Dy CSTE/APC	ANG/FIRE	CRE	PDM-GN		

Certified that this document has been designed and checked in accordance with DDC Quality Assurance Plan.

Authorised Signatory for DDC. NCDD01 Project Manager

Architecture: Design In-charge/ Coordinator | Structure: Design In-charge/ Coordinator | E&M: Design In-charge/ Coordinator

DETAIL DESIGN CONSULTANT :

ayesa — Engineering, Information, Imagination.
56, Indo-Asia House, Institutional Area, sector-44 Gurgaon - 122002 (Haryana)

DELHI METRO RAIL CORPORATION LTD.
Metro Bhawan, Fire Brigade Lane, Barakhamba Road, New Delhi-110001.

PROJECT: NOIDA - GREATER NOIDA CORRIDOR

STATION: SECTOR-101

DRAWING TITLE: STATION PARKING LAYOUT

NORTH	DRAWN BY: ADN	CHECKED BY: SHF	VERIFIED BY: SHF	APPROVED BY: PMD
	DATE: 26.12.2017	REV: R-2	SCALE: 1:400	STATUS: GFC
ORDER N° 4104-0002	DRAWING NUMBER: NGN-DTD-AR-045101-6301		SHEET NO.	SHEET SIZE A-2

DOC - NCD001

This drawing must not be other hand, copied or otherwise reproduced in whole or in part or used for any purpose without the prior written permission of DMRC.

15

NSEZ

~~DYADKY ROAD~~ ~~NSEZ~~

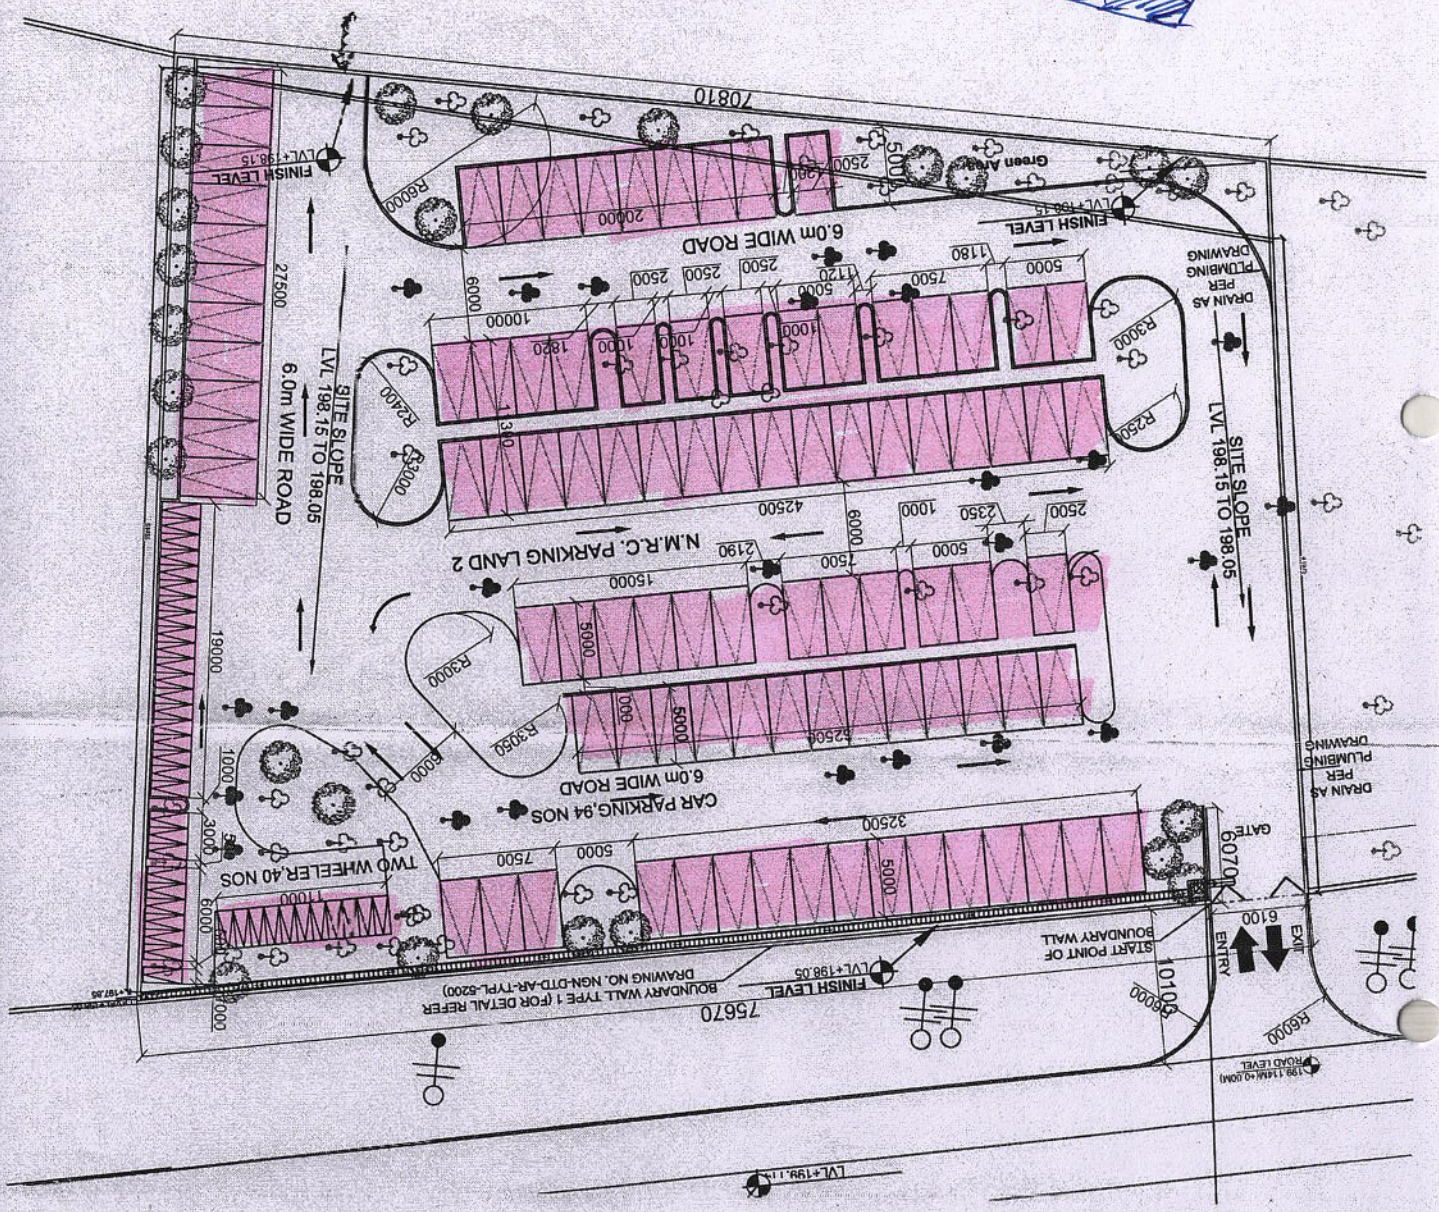

No of 4 wheeler - 96

No of 2 wheeler - 50

(158)

(12)

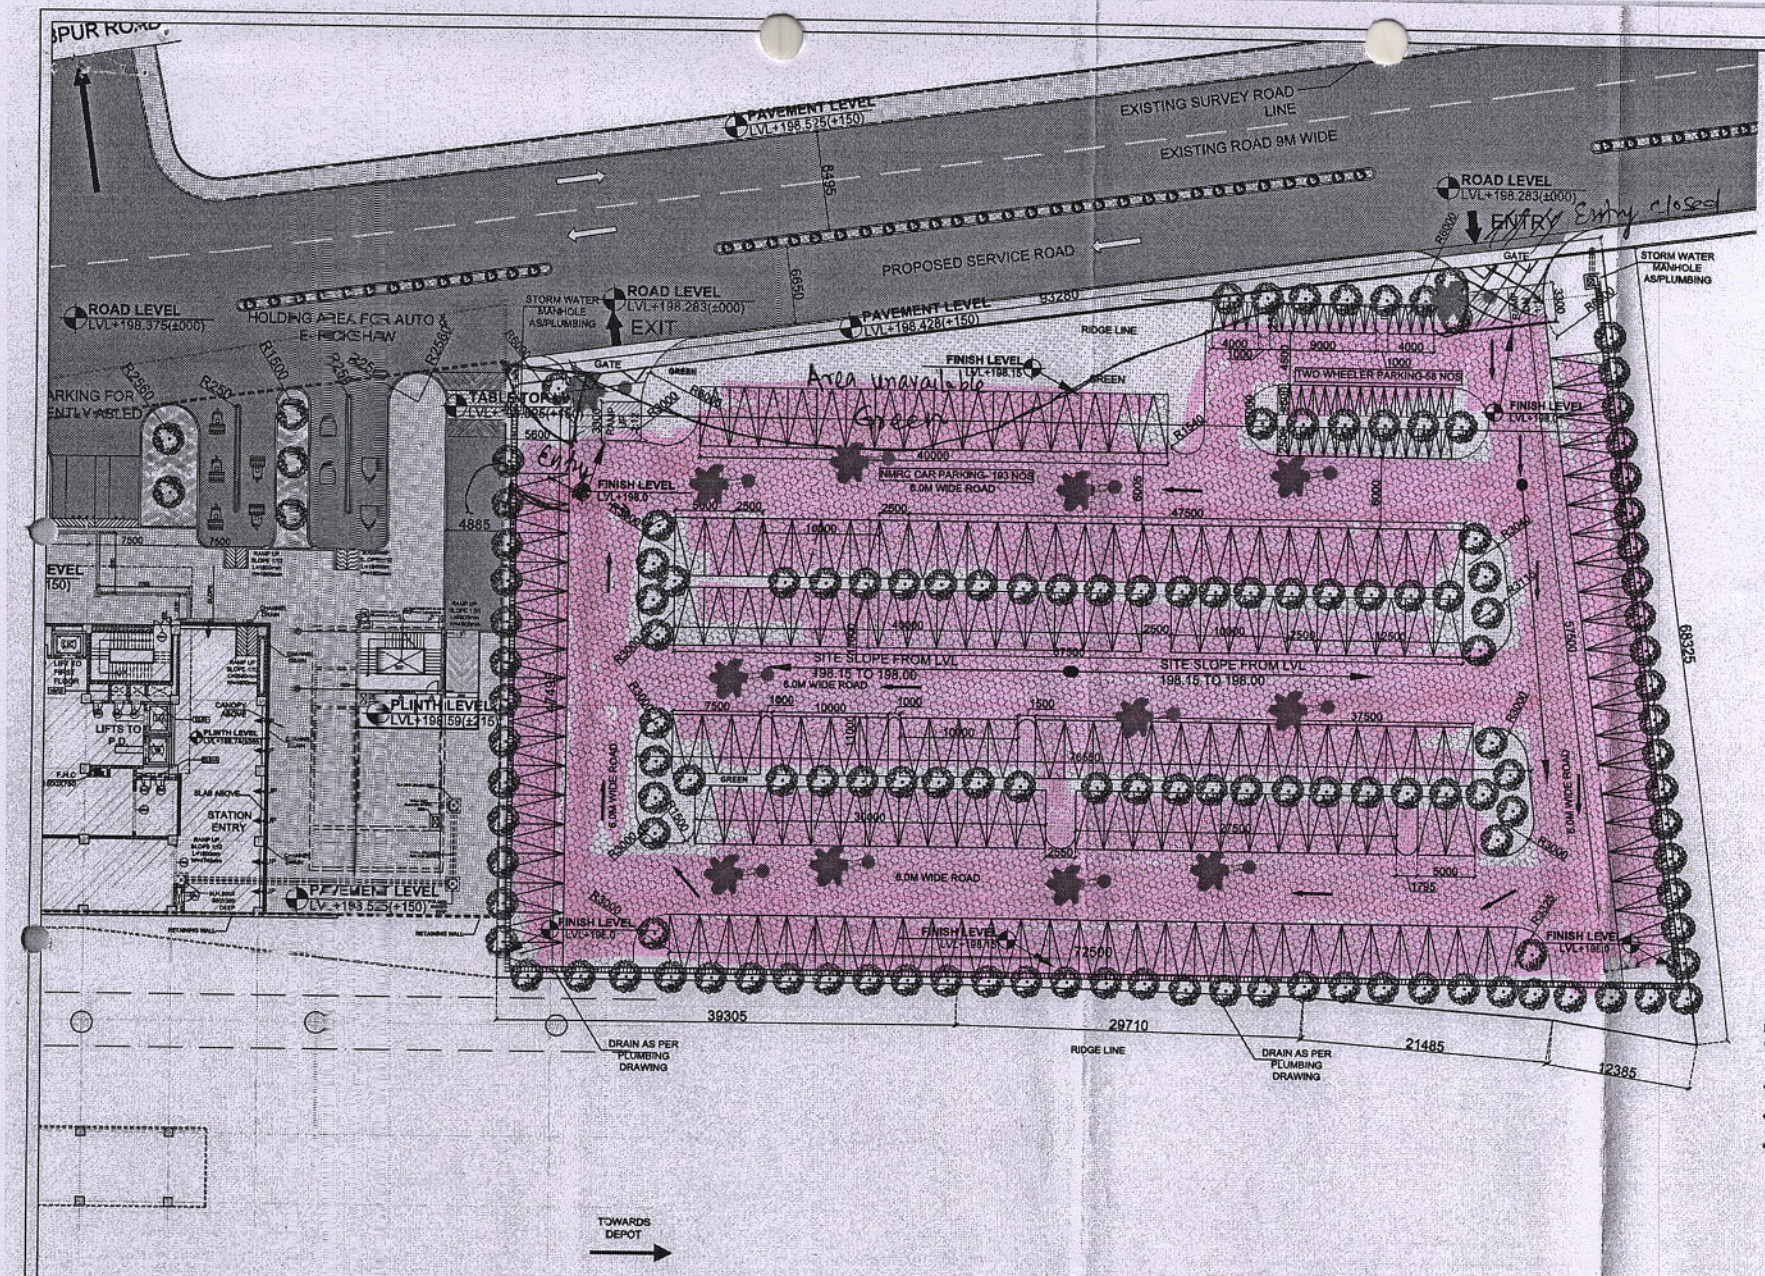

LEGEND

- LIGHT COLOUR LOAD BEARING PAVER BLOCKS IN PARKING BAY
- DARK COLOUR LOAD BEARING PAVER BLOCKS IN PARKING DRIVE WAY
- PAVER BLOCKS (LIGHT)
- PAVER BLOCKS (DARK)
- ROAD
- SHRUBS
- MAINTAINED GREEN
- WILD GREEN
- CYCLE TRACK
- DROP OFF AREA (CONCRETE)
- EXITING ELECTRICAL POLES
- EXITING TREES
- TREES TO BE CUT/RELOCATED
- PROPOSED TREES
- LAND PLAN
- AREA OF EXTENT OF EXTERNAL DEVELOPMENT

NOTES:

- FOR BOUNDARY WALL DETAIL REFER DRAWING NO. NGN-DTD-AR-TYPL-5200 (TYPE 1)
- FOR GATE DETAIL REFER DRAWING NO. NGN-DTD-AR-TYPL-5201
- FOR TYPICAL PARKING DETAIL REFER DRAWING NO. NGN-DTD-AR-TYPL-5210
- DRAIN LOCATIONS ARE TENTATIVE, FOR DETAIL REFER PLUMBING DRAWINGS.

NMRC PARKING DETAIL:

NO OF PARKING:-

- FOUR WHEELER ~~193 NOS~~ 175
- TWO WHEELER ~~47 NOS~~ 52

GENERAL NOTES:
1. ALL DIMENSIONS ARE IN MILLIMETER UNLESS NOTED OTHERWISE.
2. ALL DIMENSIONS ARE TO BE TAKEN ON SITE AND NOT MEASURED.
3. ANY DISCREPANCY MUST BE BROUGHT TO THE NOTICE OF THE DWG. BEFORE EXECUTION OWNCOM AGENCY.
4. THIS DRAWING MUST BE READ IN CONJUNCTION WITH ALL RELEVANT ARCHITECTURAL, STRUCTURAL, E-MECHANICAL & FIRE PAINTING, ELECTRICAL AND TRAFFIC MANAGEMENT DRAWINGS.
5. ALL DIMENSIONS TILL & UNTIL LEVELS ARE MEASURED FROM SAME FLOOR FINISHED LEVELS.

THIS DRAWING IS THE PROPERTY OF DELHI METRO RAIL CORPORATION LTD.

REFERENCE DRAWINGS

REVISION	DESCRIPTION	DRAWING NO.

REVISIONS

REV.	DESCRIPTION	DATE	DRAWN BY	CHECKED BY
R1	SITE LEVELS ARE MODIFIED AS PER THE SITE LEVELS, SITE CONDITIONS & DECISIONS TAKEN IN REVIEW MEETING HELD ON 23-01-2018	23.01.2018	MANISHA	S. MITTAL
R0	AS PER THE APPROVED EXTERNAL DEVELOPMENT DRAWING NO: NGN-DTD-AR-DT5083-5001	04.12.2017	MANISHA	S. MITTAL

APPROVAL OF DMRC OFFICIALS

RA	Dy CA/Arch	CA	AM/Tele	Sr. DGM/Tele	ED/S&T/P-I	
AM/Elec	DGM/Elec.	CEE	AM/Sig	AGM/S&T-II	ED/S&T/P-II	
AM/AFC	Dy CSTE/AFC	MNGR/FIRE	CRE	PGM-GH		

Certified that this document has been designed and checked in accordance with DDC Quality Assurance Plan.

Authorised Signatory for DDC. NCDDO1 Project Manager

Architecture: Design In-charge/ Coordinator
Structure: Design In-charge/ Coordinator
E&M: Design In-charge/ Coordinator

DETAIL DESIGN CONSULTANT :

ayesa — Engineering, Information, Imagination.
56, Indo-Asia House, Institutional Area, sector-44 Gurgaon - 122002 (Haryana)

DELHI METRO RAIL CORPORATION LTD.
Metro Bhawan, Fire Brigade Lane, Barakhamba Road, New Delhi-110001

PROJECT: NOIDA - GREATER NOIDA CORRIDOR

STATION: SECTOR 53

DRAWING TITLE: STATION PARKING LAYOUT (LOWER GROUND LEVEL)

DRAWN BY	CHECKED BY	VERIFIED BY	APPROVED BY
MNN	ADN	SHF	PMD
DATE: 04.12.2017	REV: R1	SCALE: 1:300	STATUS:
ORDER NO: P34-0022	DRAWING NUMBER: NGN-DTD-AR-DT5083-5300	SHEET NO.	SHEET SIZE: A-2

DOC - NCDO01

This drawing shall not be either loaned, copied or otherwise reproduced in whole or in part or used for any purpose without the prior written permission of DMRC.

152

SEC-83

13

149

NOTES:

- FOR BOUNDARY WALL DETAIL REFER DRAWING NO. NGN-DTD-AR-TYPL-5200 (TYPE 1)
- FOR GATE DETAIL REFER DRAWING NO. NGN-DTD-AR-TYPL-5201
- FOR TYPICAL PARKING DETAIL REFER DRAWING NO. NGN-DTD-AR-TYPL-5210
- CATCH BASIN AND MAN HOLE LOCATIONS ARE TENTATIVE, FOR DETAIL REFER PLUMBING DRAWINGS.

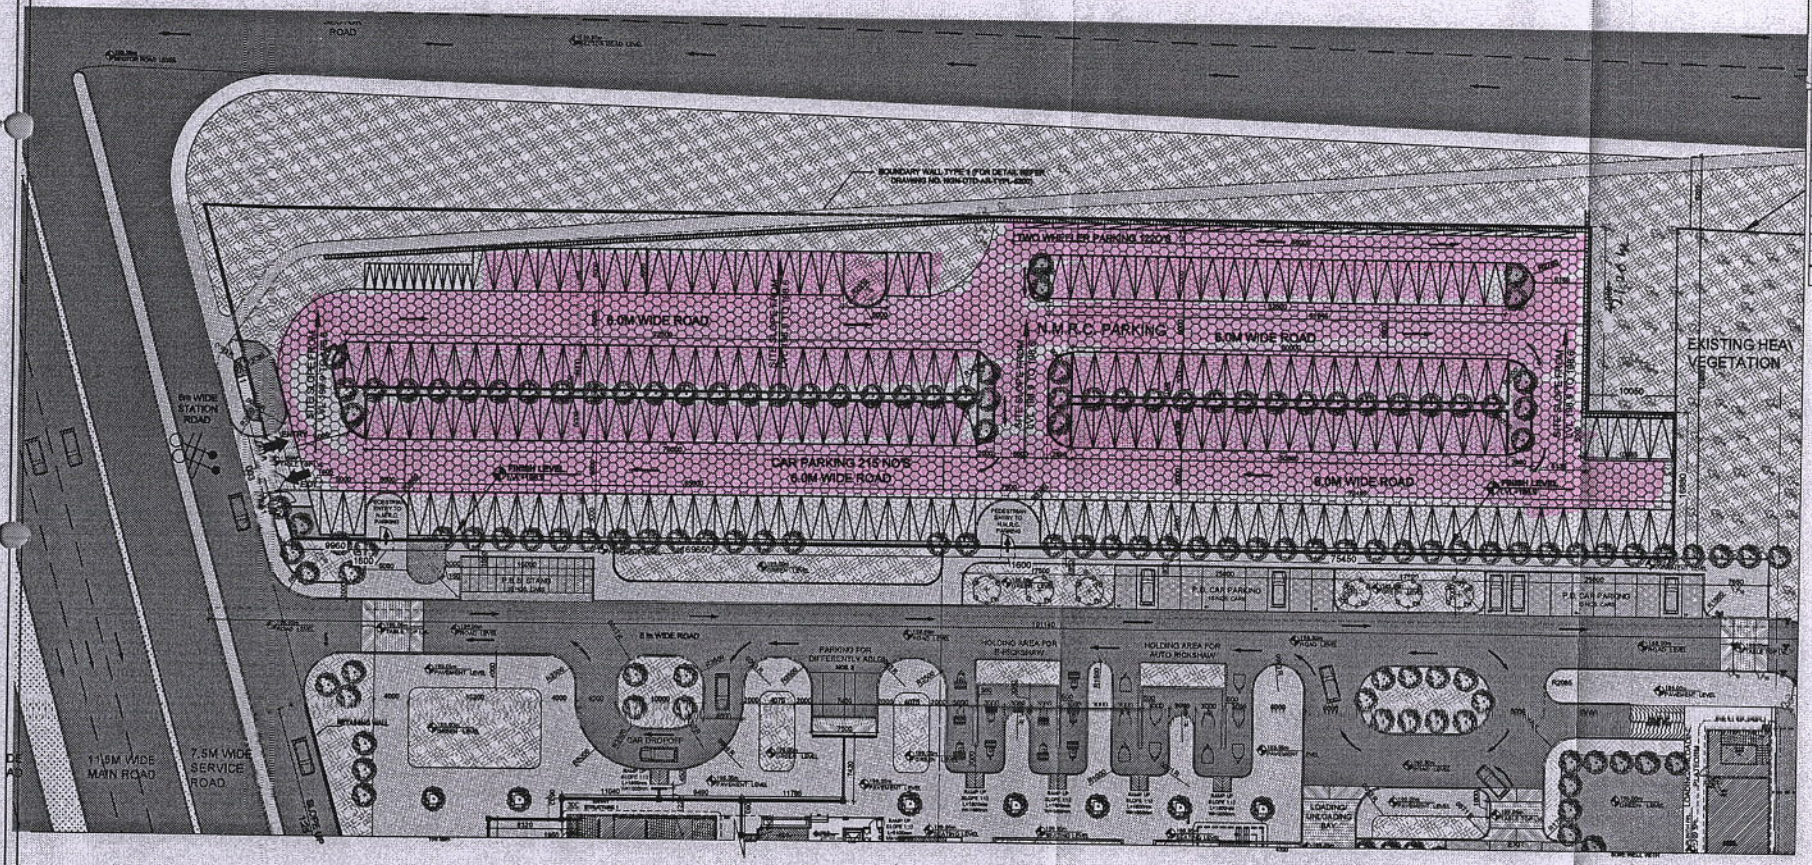

LEGEND

- LIGHT COLOUR LOAD BEARING PAVER BLOCKS IN PARKING BAY
- DARK COLOUR LOAD BEARING PAVER BLOCKS IN PARKING DRIVE WAY
- PAVER BLOCKS (LIGHT)
- PAVER BLOCKS (DARK)
- ROAD
- SHRUBS
- MAINTAINED GREEN
- WILD GREEN
- CYCLE TRACK
- DROP OFF AREA (CONCRETE)
- EXITING ELECTRICAL POLES
- EXITING TREES
- TREES TO BE CUT/RELOCATED
- PROPOSED TREES
- LAND PLAN
- AREA OF EXTENT OF EXTERNAL DEVELOPMENT

NMRC PARKING DETAIL:

NO OF PARKING:- 165

- FOUR WHEELER: ~~195~~ NOS
- TWO WHEELER : 33 NOS

SEC-137

11

GENERAL NOTES:
1. ALL DIMENSIONS ARE IN MILLIMETER UNLESS MENTIONED.
2. ALL DIMENSIONS ARE TO BE TAKEN AND NOT MEASURED.
3. ANY DISCREPANCY MUST BE ENQUIRED TO THE NOTICE OF THE DMRC BEFORE EXECUTION OF WORK AT SITE.
4. THIS DRAWING MUST BE READ IN CONJUNCTION WITH ALL RELEVANT ARCHITECTURAL, STRUCTURAL, PLUMBING & FIRE FIGHTING, ELECTRICAL AND TRAFFIC MANAGEMENT DRAWINGS.
5. ALL NOMENCLATURES, LEVELS AND MEASURES FROM MAIN FLOOR FINISH (MFF).

THIS DRAWING IS THE PROPERTY OF DELHI METRO RAIL CORPORATION LTD.

REFERENCE DRAWINGS

REVISION	DESCRIPTION	DRAWING NO.

REVISIONS

REV.	DESCRIPTION	DATE	DRAWN BY	CHECKED, BY
R4	AS PER THE INFORMATION RECEIVED FROM SITE ON 25-05-2018, PLOT SIZE DIMENSION IS CHANGED FROM ONE SIDE & ACCORDINGLY PARKING LAYOUT REVISED	25.05.2018	MANISHA	S. MITTAL
R3	AS PER THE INFORMATION RECEIVED FROM SITE ON 17-04-2018, PLOT WIDTH IS REDUCED.	25.04.2018	MANISHA	S. MITTAL
R2	AS PER SITE LEVELS, CONDITIONS & DECISION OF REVIEW MEETING HELD ON 23-01-2018	25.01.2018	MANISHA	S. MITTAL
R1	AS PER THE APPROVED EXTERNAL DEVELOPMENT DRAWING NO: NGN-DTD-AR-DSS137-5001	03.01.2018	A. KHAN	S. MITTAL

APPROVAL OF DMRC OFFICIALS

RA	Dy CA/Arch	CA	AM/Tele	Sr. SOM/Tele	ED/S&T/R-I
AM/ Elect	DGM/Elec.	CEE	AM/Sig	JGM/S&T-II	ED/S&T/R-II
AM/ APC	Dy CSTE/APC	MNGR/FIRE	CRE	PGM-GN	

Certified that this document has been designed and checked in accordance with DDC Quality Assurance Plan.

Architecture: Design In-charge/ Coordinator
Structure: Design In-charge/ Coordinator
E&M: Design In-charge/ Coordinator

Authorised Signatory for DDC: NCD091 Project Manager

DETAIL DESIGN CONSULTANT :

ayesa — Engineering. Information. Imagination.
56, Indo-Asia House, Institutional Area, sector-44
Gurgaon - 122002 (Haryana)

DELHI METRO RAIL CORPORATION LTD.
Metro Bhawan, Fire Brigade Lane, Barakhamba Road, New Delhi-110001

PROJECT: NOIDA - GREATER NOIDA CORRIDOR

STATION: SECTOR-137

DRAWING TITLE: STATION PARKING LAYOUT

NORTH	DRAWN BY: ADN	CHECKED BY: SHF	VERIFIED BY: SHF	APPROVED BY: PMD
	DATE: 26.12.2017	REV: R4	SCALE: 1:400	STATUS: GFC
ORDER NO: P36-0002	DRAWING NUMBER: NGN-DTD-AR-DSS137-5301		SHEET NO.	SHEET SIZE: A2

DDC: NCD091

This drawing must not be either lessed, copied or otherwise reproduced in whole or in part or used for any purpose without the prior written permission of DMRC.

148

NOTES:

- FOR BOUNDARY WALL DETAIL REFER DRAWING NO. NGN-DTD-AR-TYPL-5200 (TYPE 2)
- FOR GATE DETAIL REFER DRAWING NO. NGN-DTD-AR-TYPL-5201
- FOR TYPICAL PARKING DETAIL REFER DRAWING NO. NGN-DTD-AR-TYPL-5210
- CATCH BASIN AND MAN HOLE LOCATIONS ARE TENTATIVE, FOR DETAIL REFER PLUMBING DRAWINGS.

LEGEND

- LOAD BEARING PAVER BLOCKS(LIGHT)
- LOAD BEARING PAVER BLOCKS (DARK)
- PAVER BLOCKS (LIGHT)
- ROAD
- SHRUBS
- MAINTAINED GREEN
- WILD GREEN
- CYCLE TRACK
- DROP OFF AREA (CONCRETE)
- FLOOR TILES AS PER BOQ
- PAVER BLOCKS (DARK)
- EXISTING ELECTRICAL POLES
- EXISTING TREES
- TREES TO BE CUT/RELOCATED
- PROPOSED TREES
- LAND PLAN
- AREA OF EXTENT OF EXTERNAL DEVELOPMENT

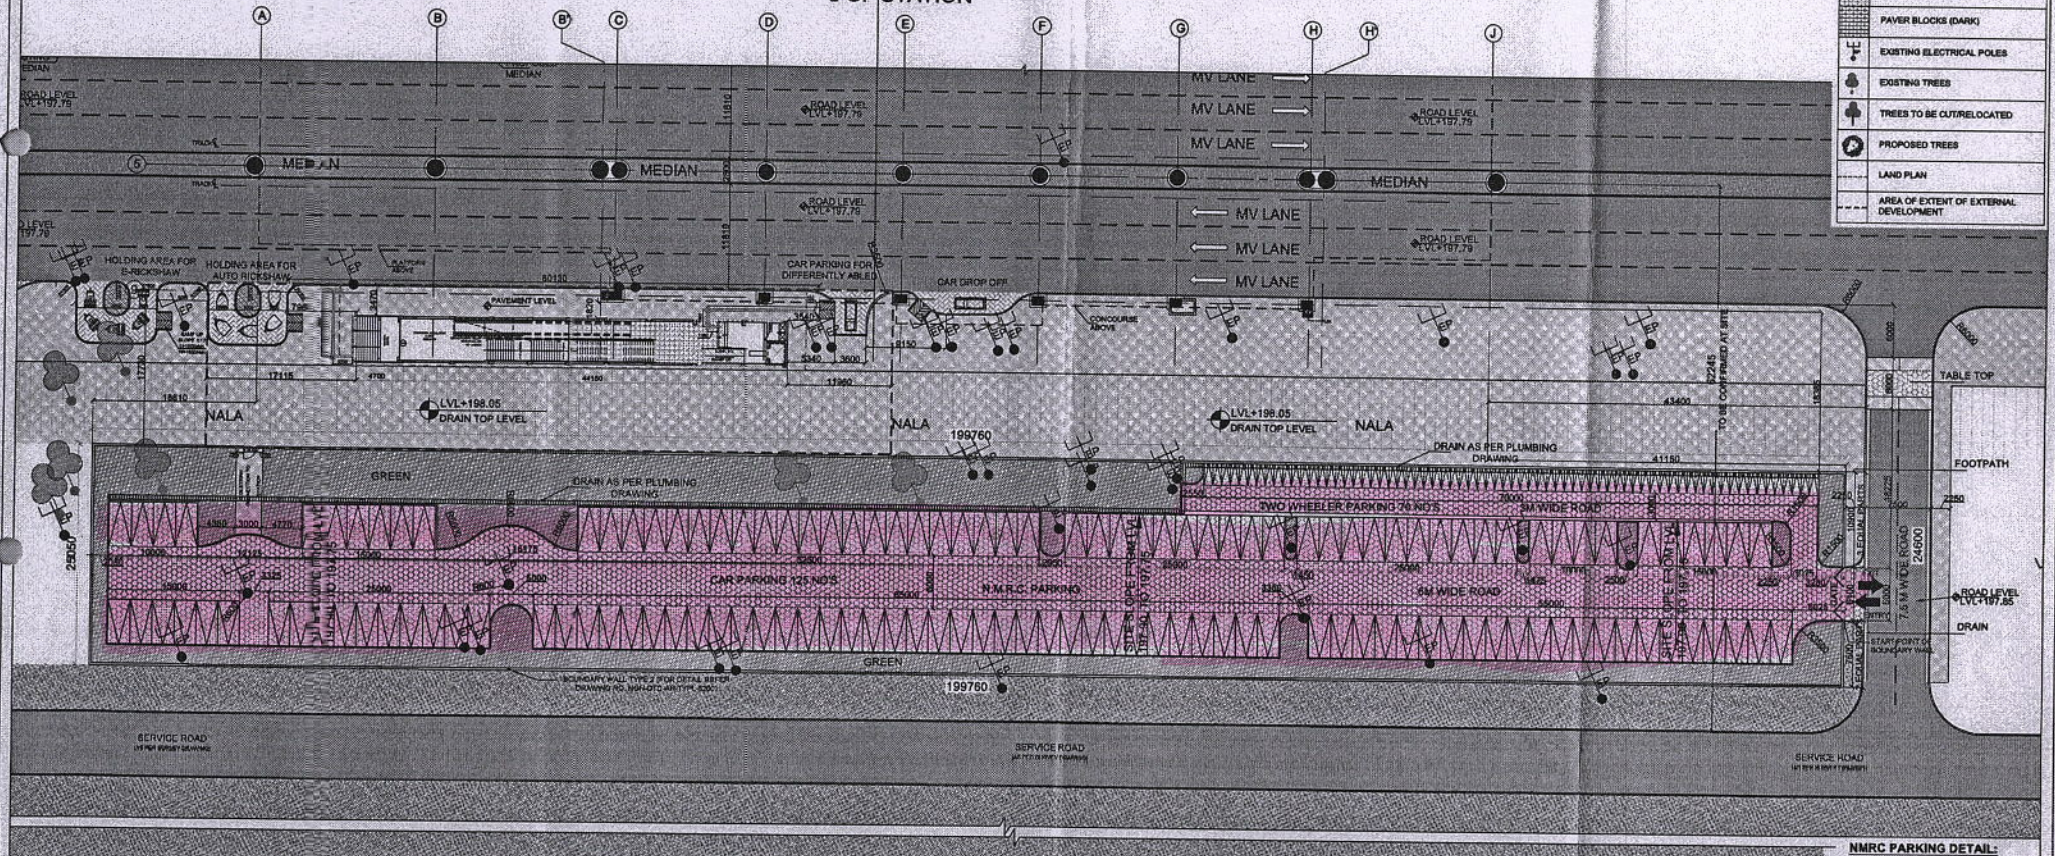

NMRC PARKING DETAIL:

NO OF PARKING:-

- FOUR WHEELER:125 NOS
- TWO WHEELER : 70 NOS

REVISIONS

REV.	DESCRIPTION	DATE	DRAWN BY	CHECKED BY
R1	STATION PARKING LEVELS ARE REVISED AS PER THE LATEST LEVELS RECEIVED ON 9-3-2018 BY DMRC.	23.03.2018	MANISHA	S. MITTAL
R0	AS PER THE APPROVED EXTERNAL DEVELOPMENT DRAWING NO: NGN-DTD-AR-09S142-5001	03.01.2018	A. KHAN	S. MITTAL

REFERENCE DRAWINGS

REVISION	DESCRIPTION	DRAWING NO.

APPROVAL OF DMRC OFFICIALS

RA	Dy CAA/Arch	CA	AM/Tele	Sr. DGM/Tele	EDS/ST/P-I	
AM/ Elect	DGM/Elec.	CES	AM/Sig	JGM/S&T-II	EDS/ST/P-II	
AM/ AFC	Dy CETE/AFC	MNGR/FIRE	CRE	PDM-GM		

Certified that this document has been designed and checked in accordance with DDC Quality Assurance Plan.

Authorised Signatory for DDC. NGD001 Project Manager

Architecture: Design In-charge/ Coordinator | Structure: Design In-charge/ Coordinator | E&M: Design In-charge/ Coordinator

DETAIL DESIGN CONSULTANT :

ayesa — Engineering Information, Imagination.
56, Indo-Asia House, Institutional Area, sector-44
Gurgaon - 122002 (Haryana)

DELHI METRO RAIL CORPORATION LTD.
Metro Bhawan, Fire Brigade Lane, Barakhamba Road, New Delhi-110001

PROJECT: NOIDA - GREATER NOIDA CORRIDOR

STATION: SECTOR-142

DRAWING TITLE: STATION PARKING LAYOUT

NORTH	DRAWN BY: ADN	CHECKED BY: SHF	VERIFIED BY: SHF	APPROVED BY: PMD
	DATE: 15.12.2017	REV: R-1	SCALE: 1:400	STATUS: GFC
ORDER NO: P56-0022	DRAWING NUMBER: NGN-DTD-AR-09S142-5301		SHEET NO.	SHEET SIZE: A-2

DDC-WD001

SEC-142

10

SECTOR - 143

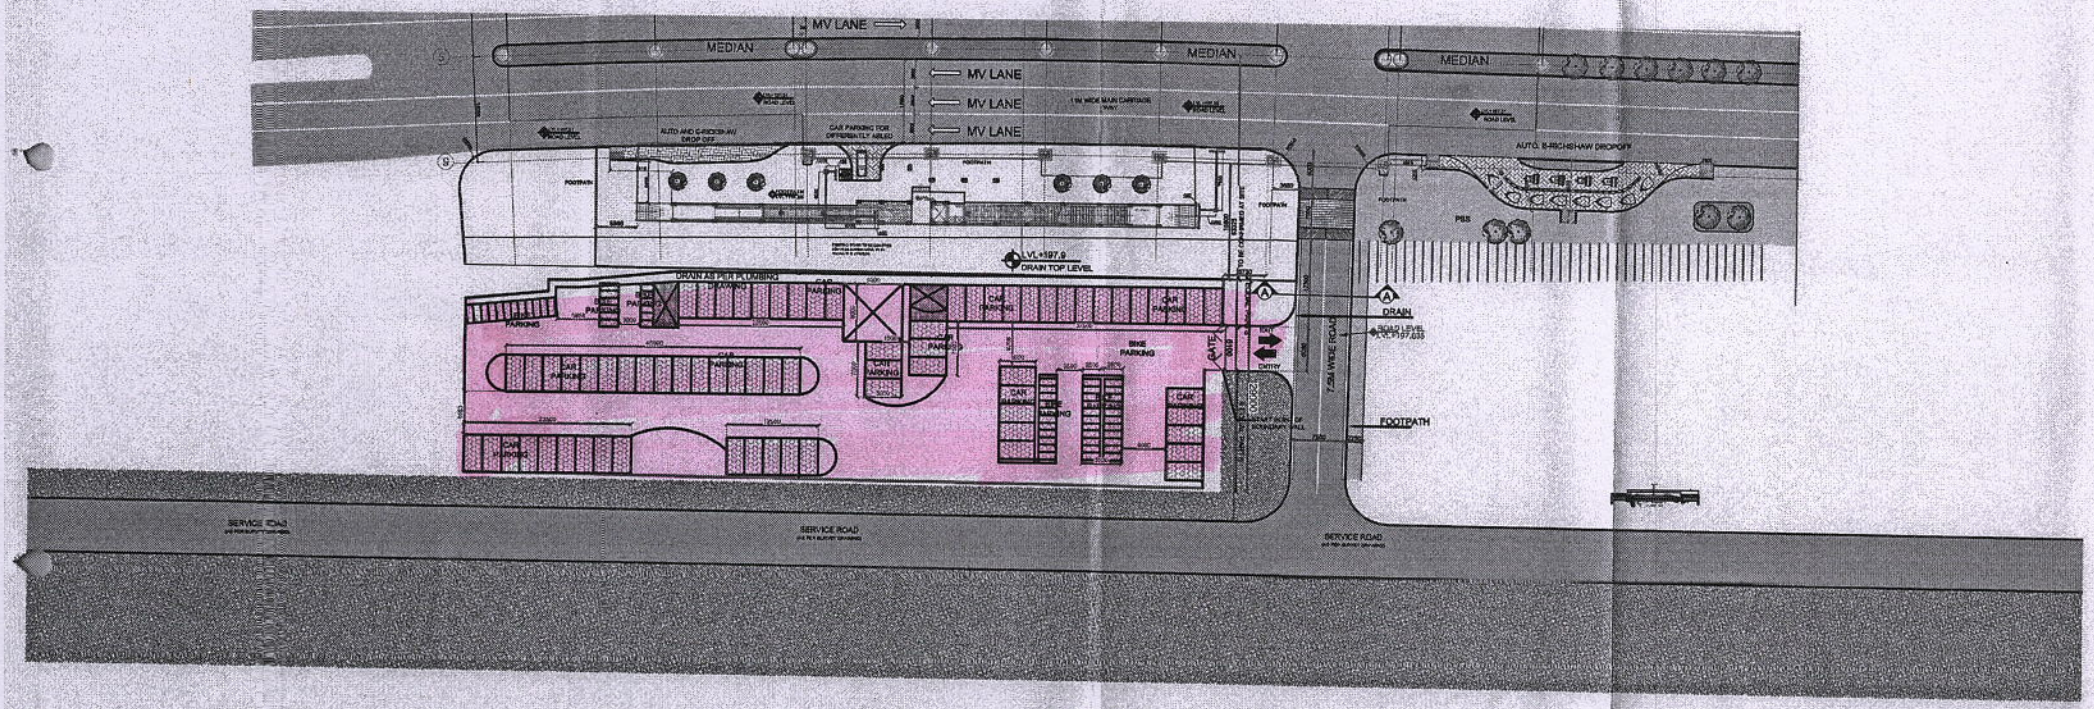

No's of 4 wheeler - 70

No's of 2 wheeler - 54

SEC-143

SECTOR-144

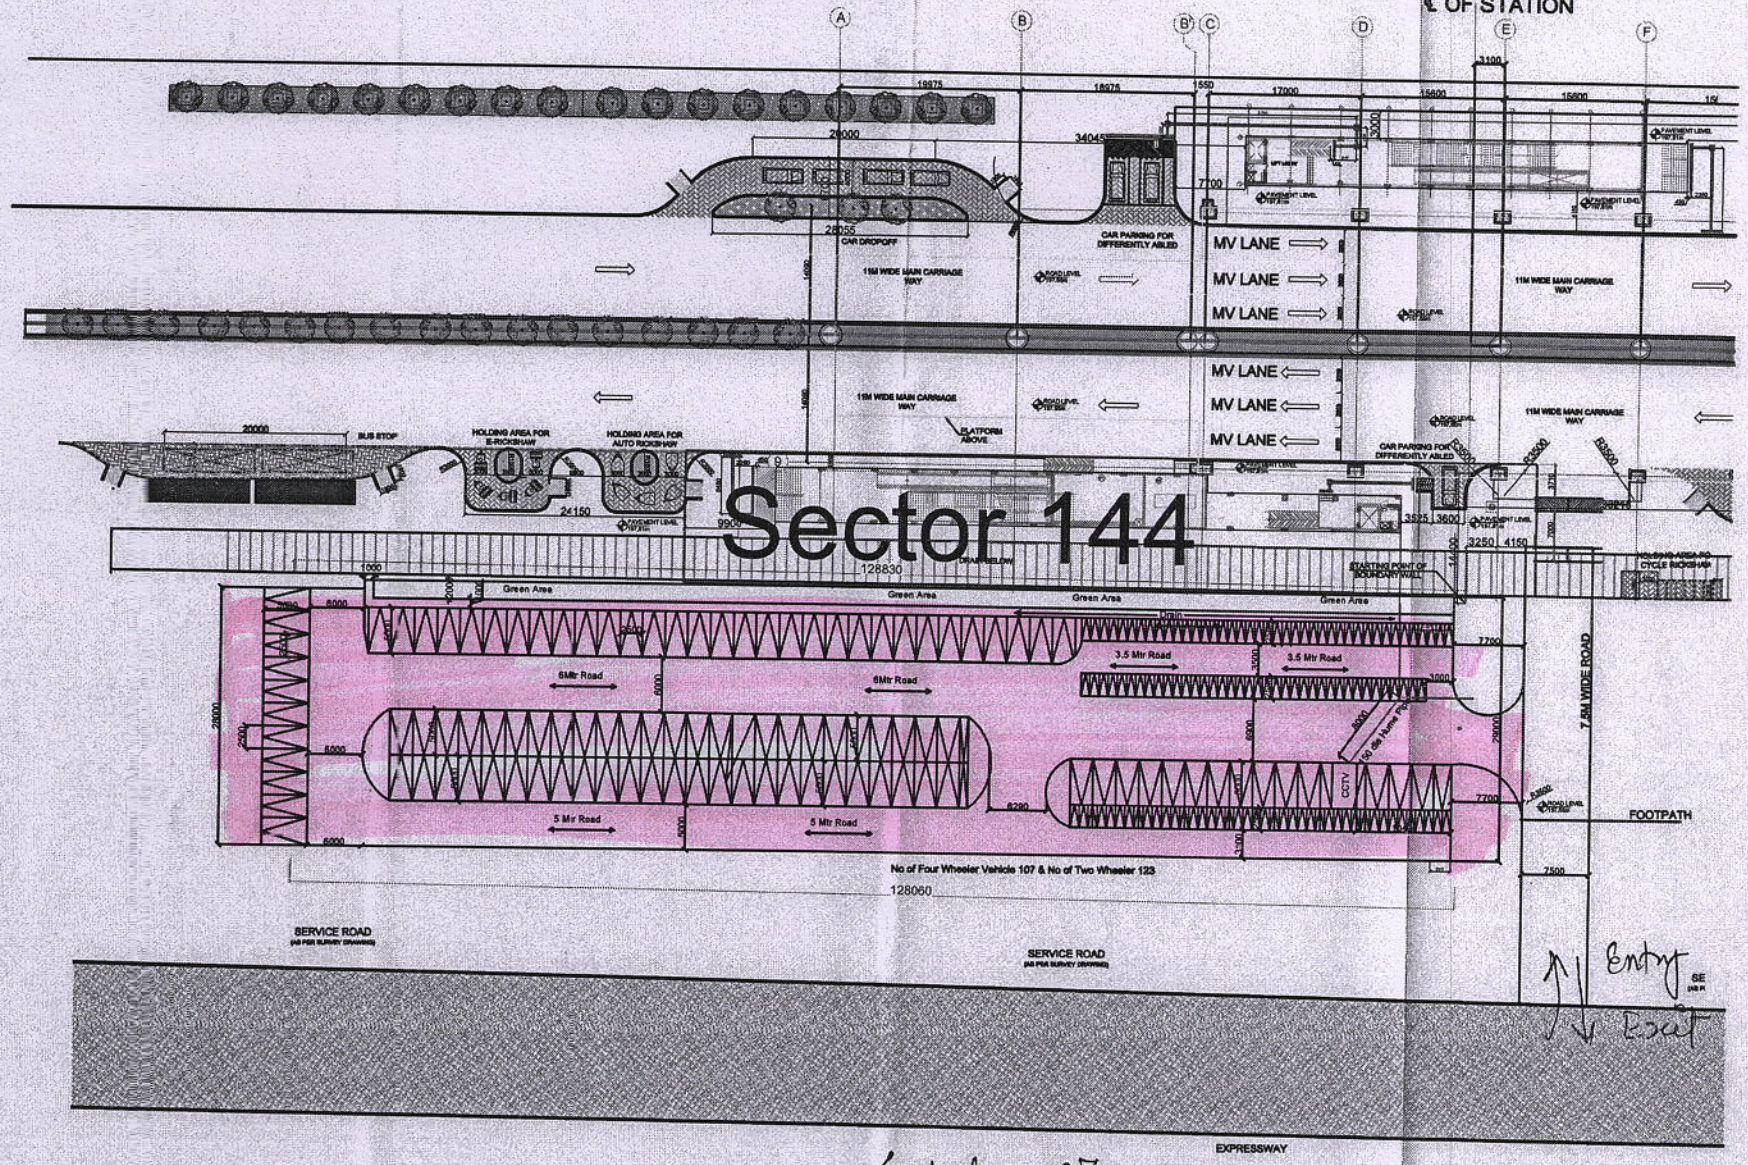

4 wheeler - 107
2 wheeler - 123

SEC-144

146

8

145

SECTOR-145

NOTES:

- FOR BOUNDARY WALL DETAIL REFER DRAWING NO. NGN-DTD-AR-TYPL-5200 (TYPE 2)
- FOR GATE DETAIL REFER DRAWING NO. NGN-DTD-AR-TYPL-5201
- FOR TYPICAL PARKING DETAIL REFER DRAWING NO. NGN-DTD-AR-TYPL-5210
- CATCH BASIN AND MAN HOLE LOCATIONS ARE TENTATIVE, FOR DETAIL REFER PLUMBING DRAWINGS.

LEGEND

- LOAD BEARING PAVER BLOCKS (LIGHT)
- LOAD BEARING PAVER BLOCKS (DARK)
- PAVER BLOCKS (LIGHT)
- ROAD
- SHRUBS
- MAINTAINED GREEN
- WILD GREEN
- CYCLE TRACK
- DROP OFF AREA (CONCRETE)
- FLOOR TILES AS PER BOQ
- PAVER BLOCKS (DARK)
- EXISTING ELECTRICAL POLES
- EXISTING TREES
- TREES TO BE CUT/RELOCATED
- PROPOSED TREES
- LAND PLAN
- AREA OF EXTENT OF EXTERNAL DEVELOPMENT

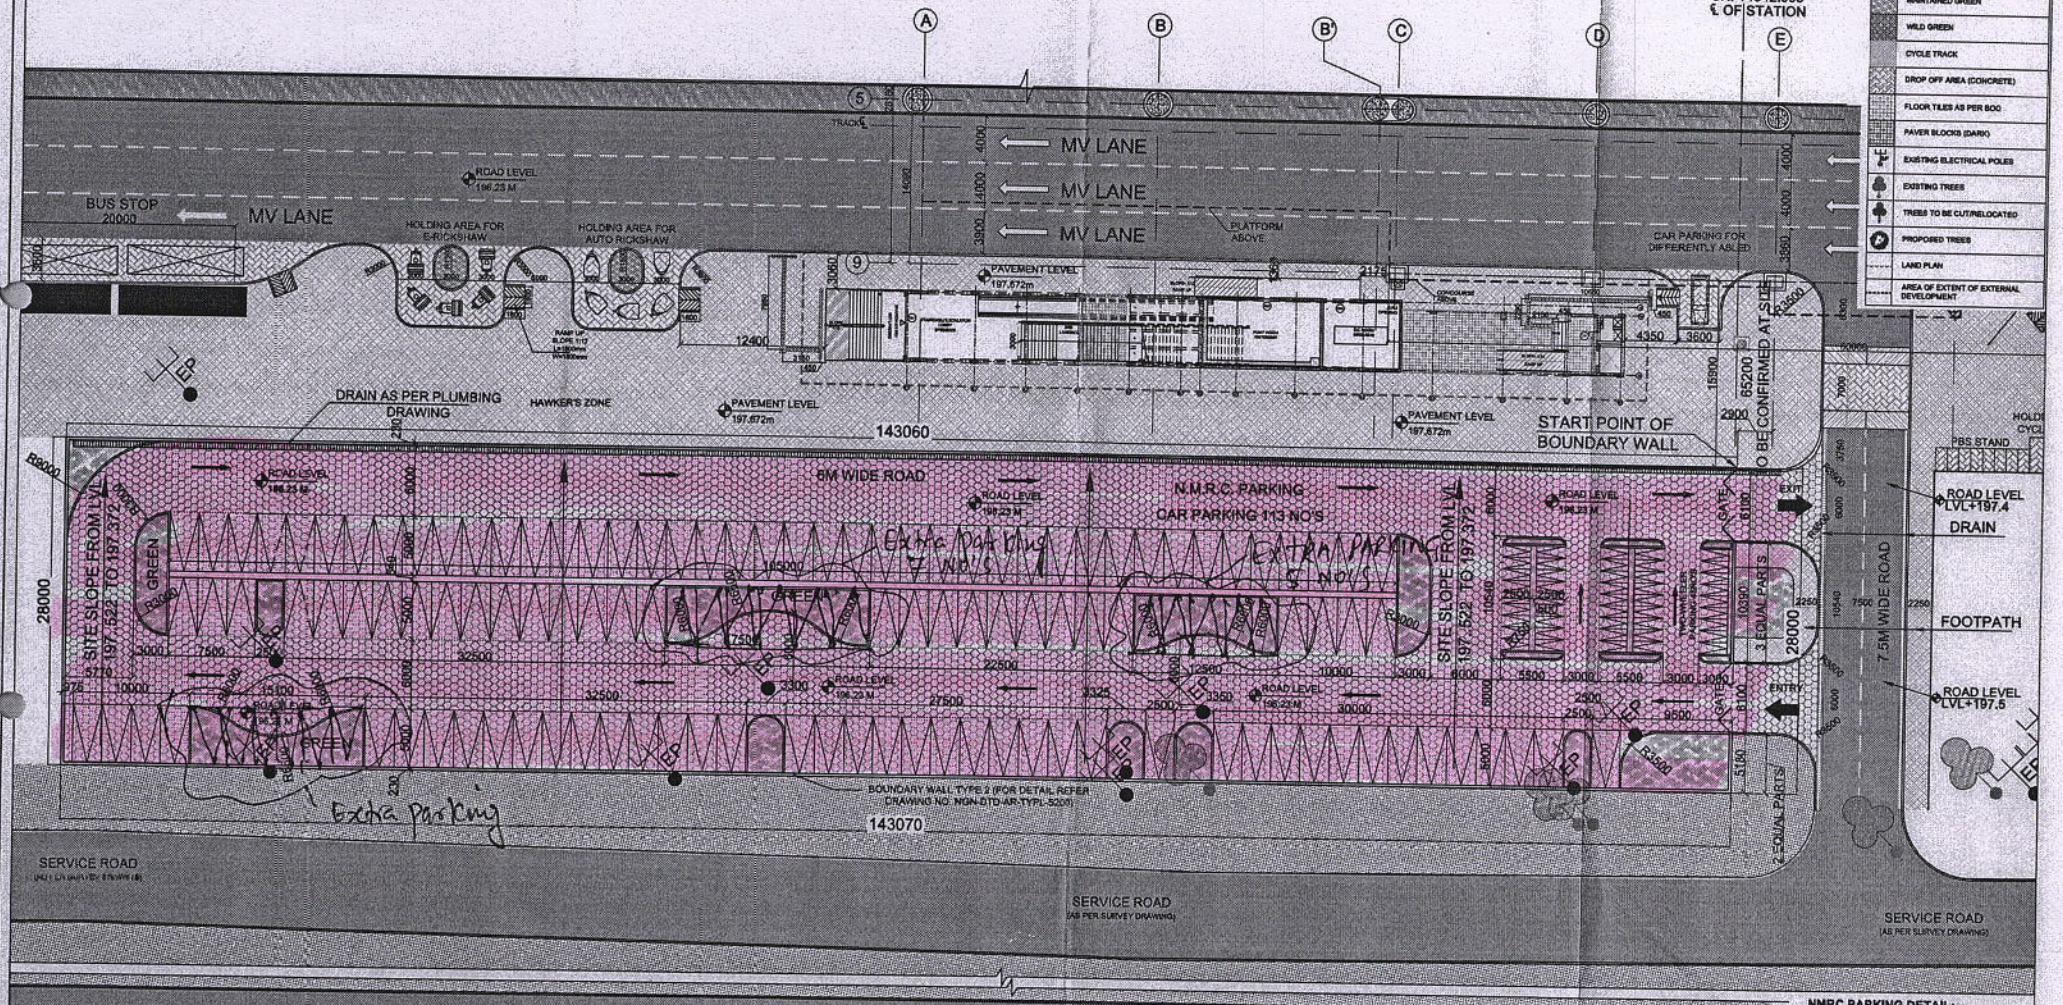

NMRC PARKING DETAIL:

NO OF PARKING:- 137

- FOUR WHEELER: ~~113 NOS~~
- TWO WHEELER : 45 NOS

GENERAL NOTES

1. ALL DIMENSIONS ARE IN MILLIMETER UNLESS OTHERWISE.
2. ALL DIMENSIONS ARE TO BE READ AND NOT MEASURED.
3. ANY DISCREPANCY MUST BE BROUGHT TO THE NOTICE OF THE DMRC BEFORE EXECUTION OF WORK AT SITE.
4. THIS DRAWING MUST BE READ IN CONJUNCTION WITH ALL RELEVANT ARCHITECTURAL, STRUCTURAL, PLUMBING & FIRE FIGHTING DRAWINGS AND OTHER ENGINEERING DRAWINGS.
5. ALL DIMENSIONS ON ALL LEVELS TO BE VERIFIED BY CONTRACTOR.

REFERENCE DRAWINGS

REVISION	DESCRIPTION	DRAWING NO.

REVISIONS

REV.	DESCRIPTION	DATE	DRAWN BY	CHECKED BY
R1	STATION PARKING LEVELS ARE REVISED AS PER THE LATEST LEVELS RECEIVED ON 9-3-2018 BY DMRC.	29.03.2018	MANISHA	S. MITTAL
R0	AS PER THE APPROVED EXTERNAL DEVELOPMENT DRAWING NO: NGN-DTD-AR-128147-5001	09.01.2018	A. KHAN	S. MITTAL

APPROVAL OF DMRC OFFICIALS

RA	Dy CAM/Arch	CA	AM/Tele	Sr. DGM/Tele	ED/S&T/F-I
AM/ Elect	DGM/Elec.	CEE	AM/Sig	DGM/S&T-S	ED/S&T/F-II
AM/ APC	Dy CSTE/APC	MNGR/FIRE	CRE	PDM-SH	

Certified that this document has been designed and checked in accordance with DDC Quality Assurance Plan.

Authorised Signatory for DDC: HCDC001 Project Manager

Architecture Design In-charge/ Coordinator | Structure Design In-charge/ Coordinator | E&M Design In-charge/ Coordinator

DETAIL DESIGN CONSULTANT :

ayesa Engineering. Information. Imagination.
56, Indo-Asia House, Institutional Area, sector-44
Gurgaon - 122002 (Haryana)

DELHI METRO RAIL CORPORATION LTD.
Metro Bhawan, Fire Brigade Lane, Barakhamba Road, New Delhi-110001

PROJECT: NOIDA - GREATER NOIDA CORRIDOR

STATION: SECTOR-145

DRAWING TITLE: STATION PARKING LAYOUT

NORTH	DRAWN BY : ADN	CHECKED BY: SHF	VERIFIED BY: SHF	APPROVED BY: PMD
	DATE: 18.12.2017	REV: R-1	SCALE: 1:300	STATUS: GFC
ORDER NO: P-06-0002	DRAWING NUMBER: NGN-DTD-AR-128147-5301		SHEET NO.	SHEET SIZE: A-2

DRC-HCDC001

This drawing must not be either loaned, copied or otherwise reproduced in whole or in part or used for any purpose without the prior written permission of DMRC.

SEC-145

7

SECTOR-146

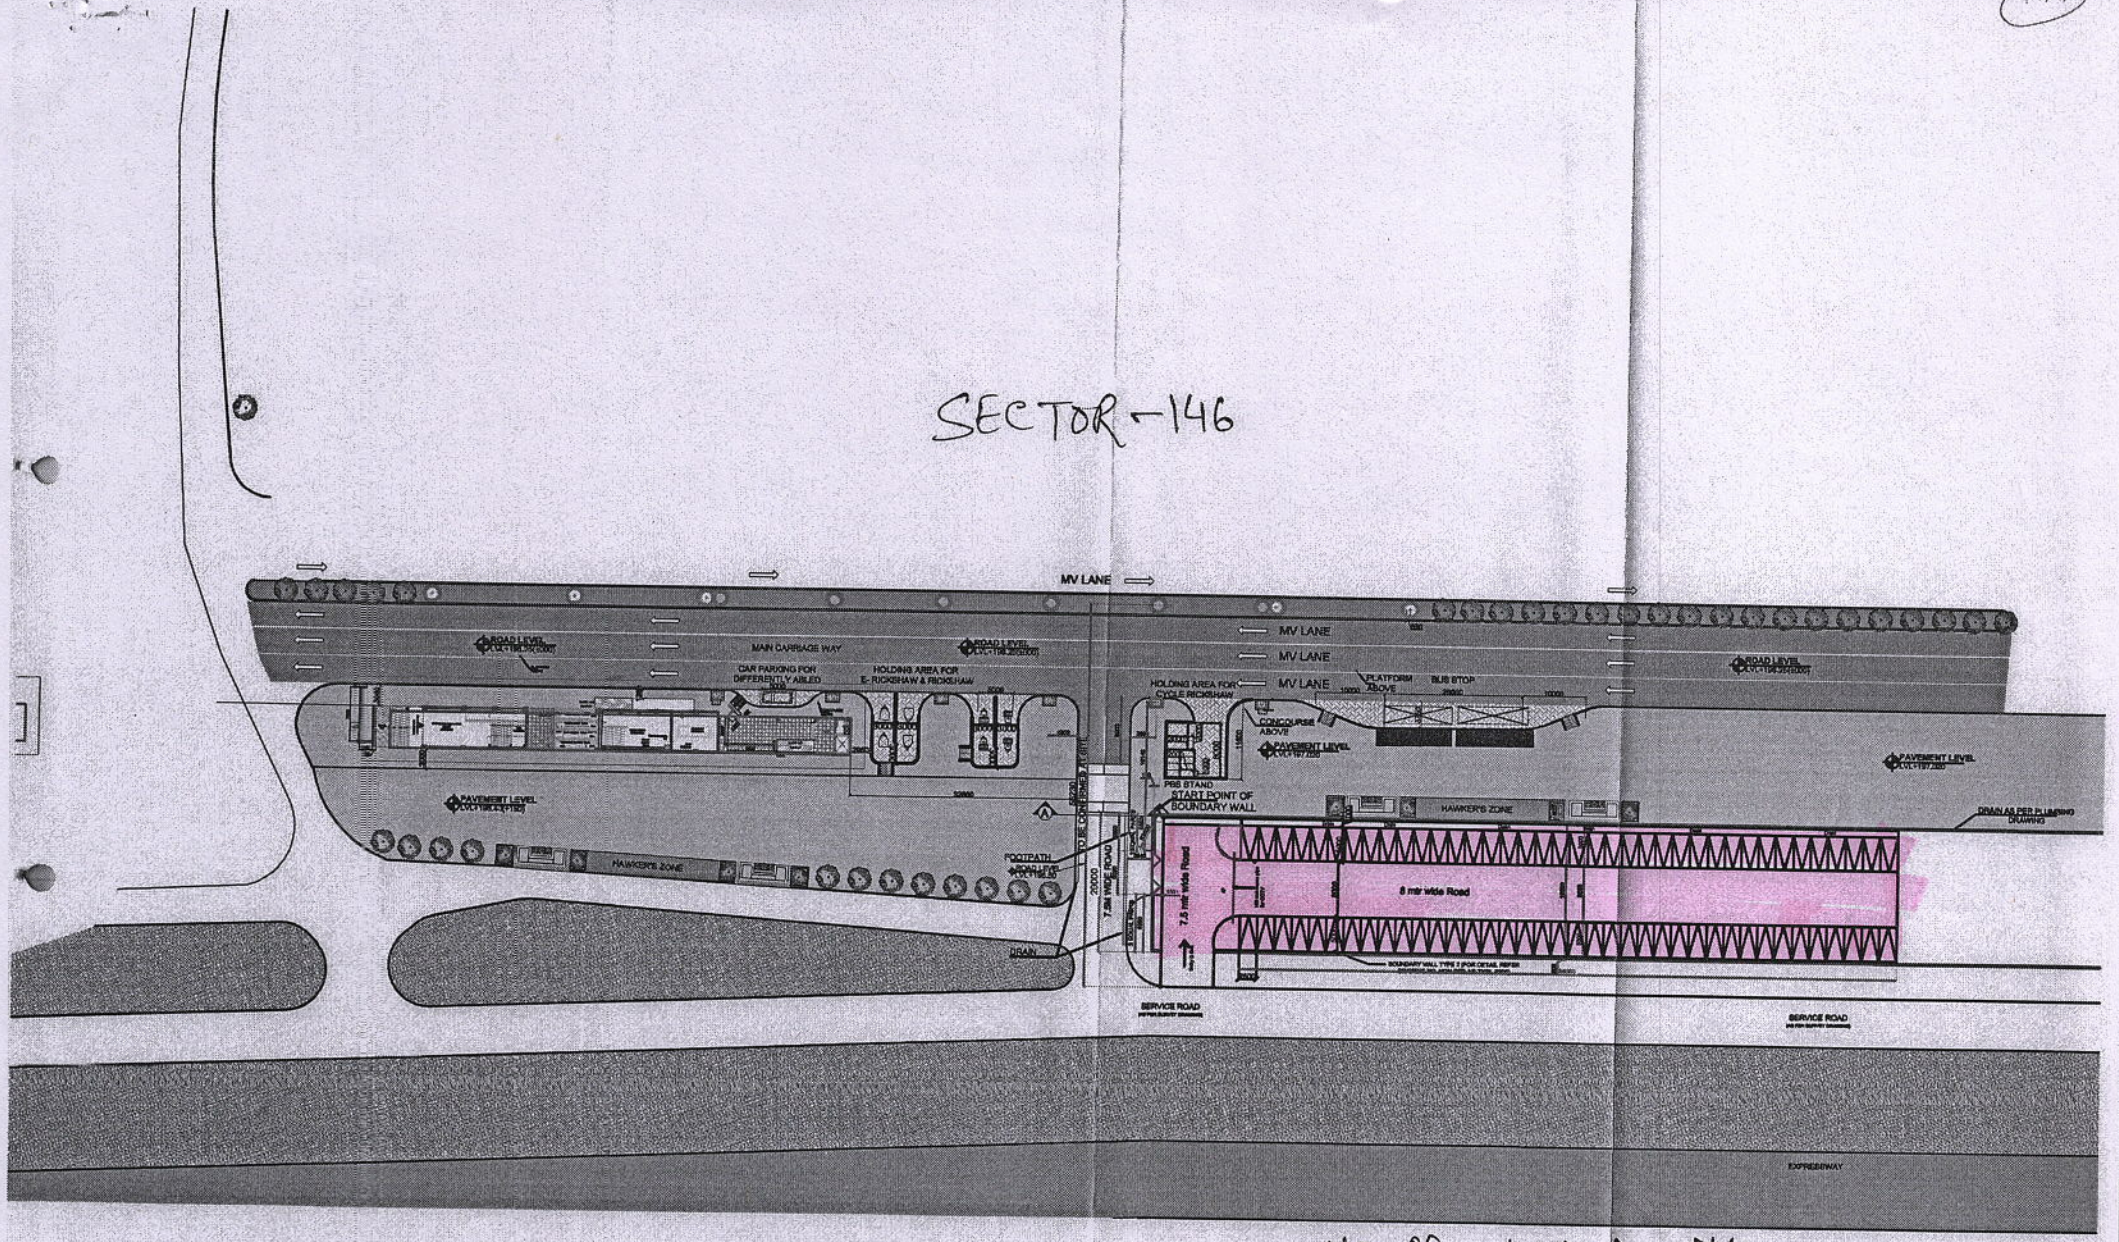

No of 4 wheeler - 76

No of 2 wheeler - Nil

SEC-146

SECTOR-146 147
CH: 17556.307
℄ OF STATION

NOTES:
- FOR BOUNDARY WALL DETAIL REFER DRAWING NO. NGN-DTD-AR-TYPL-5200 (TYPE 2)
- FOR GATE DETAIL REFER DRAWING NO. NGN-DTD-AR-TYPL-5201
- FOR TYPICAL PARKING DETAIL REFER DRAWING NO. NGN-DTD-AR-TYPL-5210
- CATCH BASIN AND MAN HOLE LOCATIONS ARE TENTATIVE, FOR DETAIL REFER PLUMBING DRAWINGS.

LEGEND
- LOAD BEARING PAVER BLOCKS (LIGHT)
- LOAD BEARING PAVER BLOCKS (DARK)
- PAVER BLOCKS (LIGHT)
- ROAD
- SHRUBS
- MAINTAINED GREEN
- WILD GREEN
- CYCLE TRACK
- DROP OFF AREA (CONCRETE)
- FLOOR TILES AS PER BOQ
- PAVER BLOCKS (DARK)
- EXISTING ELECTRICAL POLES
- EXISTING TREES
- TREES TO BE CUT/RELOCATED
- PROPOSED TREES
- LAND PLAN
- AREA OF EXTENT OF EXTERNAL DEVELOPMENT

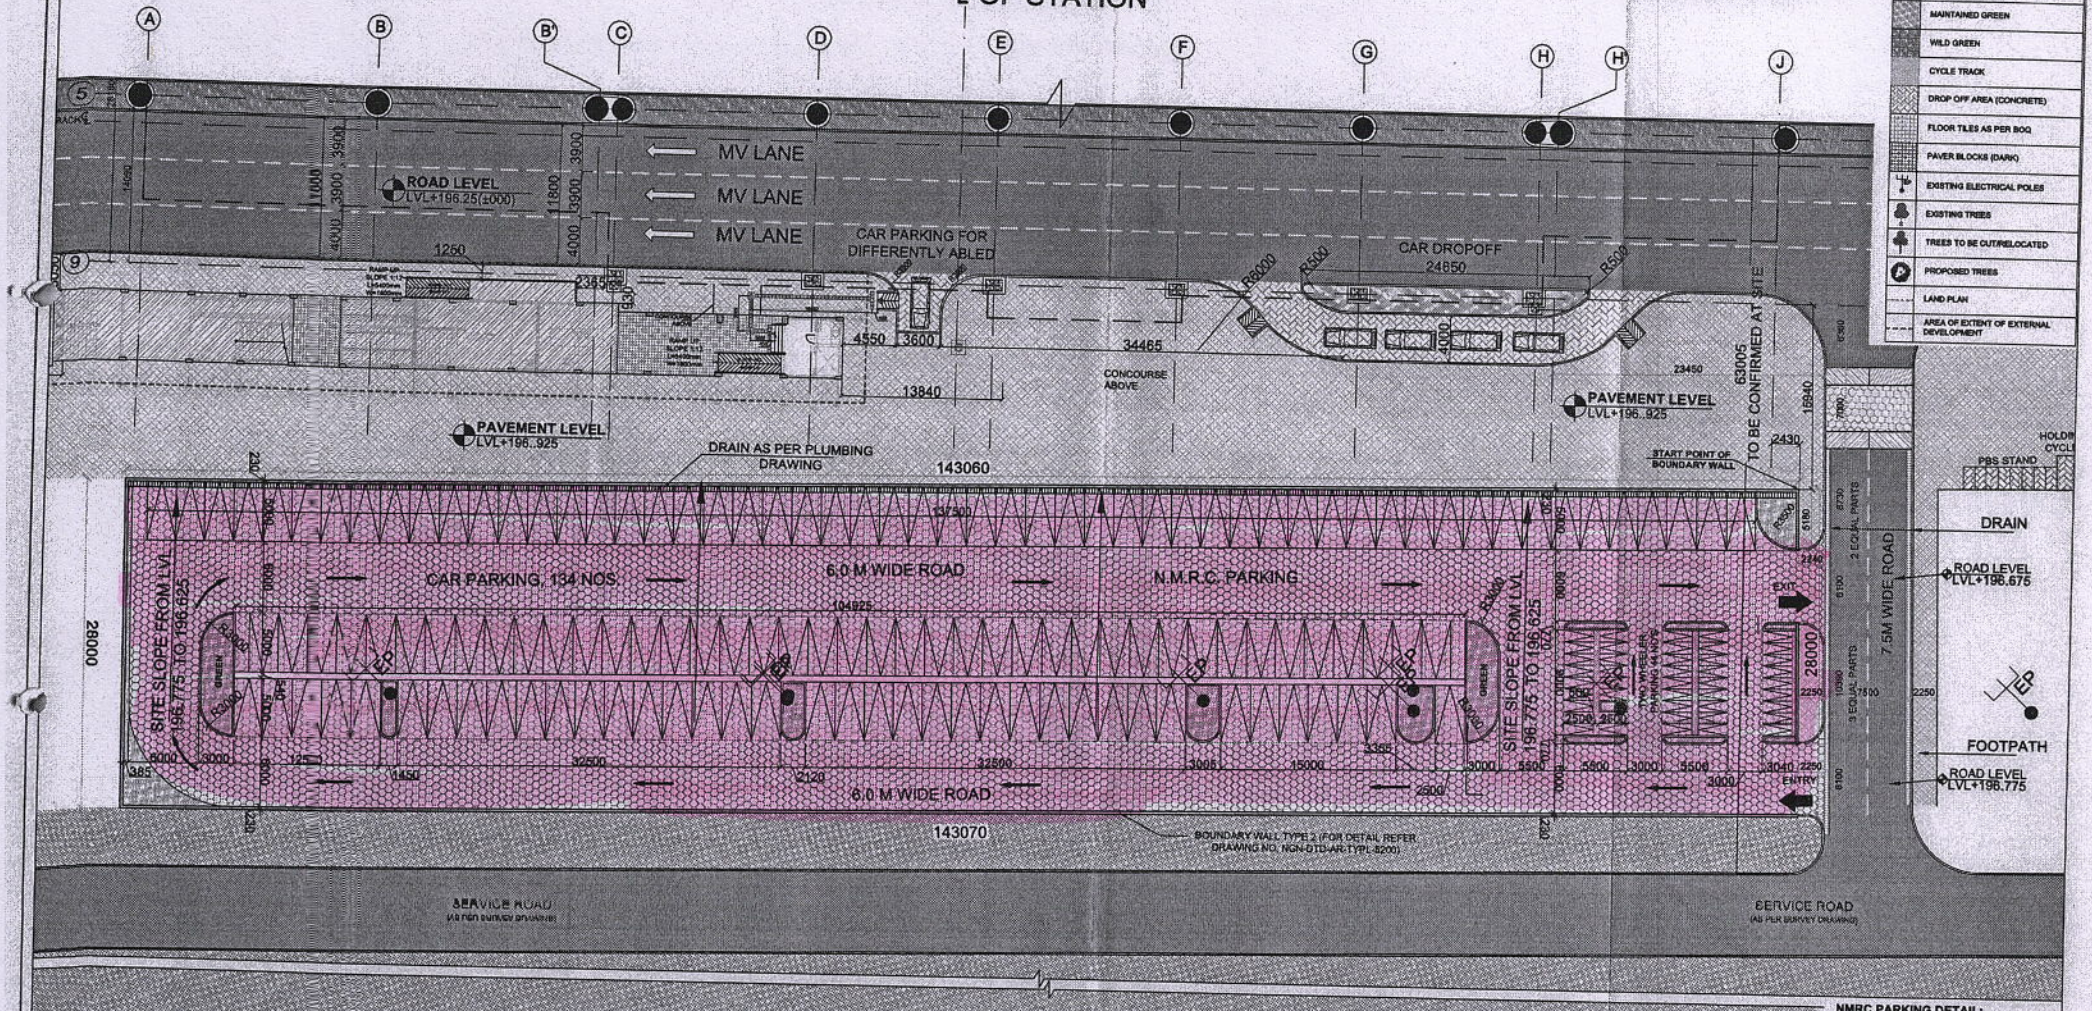

NMRC PARKING DETAIL:
NO OF PARKING:-
- FOUR WHEELER: ~~134~~ 131 NOS
- TWO WHEELER: ~~44~~ NOS 43

GENERAL NOTES:
1. ALL DRAWINGS ARE IN MILLIMETER UNLESS MENTIONED.
2. ALL DIMENSIONS ARE TO BE TAKEN AND NOT MEASURED.
3. ANY DISCREPANCY MUST BE BROUGHT TO THE NOTICE OF THE ENGG. BEFORE EXECUTION OF WORK AT SITE.
4. THIS DRAWING MUST BE READ IN CONJUNCTION WITH ALL ARCHITECTURAL, ARCHITECTURAL, STRUCTURAL, PLUMBING & FIRE FIGHTING, ELECTRICAL AND TRAFFIC MANAGEMENT DRAWINGS.
5. ALL DRAWINGS ARE ALL & UPTO LEVELS ARE REFERRED FROM MAIN FLOOR FINISH ON LINELS.

REFERENCE DRAWINGS

REVISION	DESCRIPTION	DRAWING NO.

REVISIONS

REV.	DESCRIPTION	DATE	DRAWN BY	CHECKED. BY
R1	STATION PARKING LEVELS ARE REVISED AS PER THE LATEST LEVELS RECEIVED ON 9-3-2018 BY DMRC.	23.03.2018	MANISHA	S. MITTAL
R0	AS PER THE APPROVED EXTERNAL DEVELOPMENT DRAWING NO: NGN-DTD-AR-145146-5001	03.01.2018	A. KHAN	S. MITTAL

APPROVAL OF DMRC OFFICIALS

RA	Dy CA/Arch	CA	AM/Tele	Sr. DGM/Tele	EE/S&T/P-I	
AM/ Elect	DGM/Elec.	CEE	AM/Sig	JGM/S&T-II	EE/S&T/P-II	
AM/ APC	Dy CE/E&APC	MNGR/FIRE	CRE	PGM-GH		

Certified that this document has been designed and checked in accordance with DDC Quality Assurance Plan.

Architecture: Design In-charge/ Coordinator
Structure: Design In-charge/ Coordinator
E&M: Design In-charge/ Coordinator
Authorised Signatory for DDC, NCDDCI Project Manager

DETAIL DESIGN CONSULTANT :
ayesa — Engineering. Information. Imagination.
56, Indo-Asia House, Institutional Area, sector-44 Gurgaon - 122002 (Haryana)

DELHI METRO RAIL CORPORATION LTD.
Metro Bhawan, Fire Brigade Lane, Barakhamba Road, New Delhi-110001

PROJECT: NOIDA - GREATER NOIDA CORRIDOR
STATION: SECTOR-~~146~~ 147
DRAWING TITLE: STATION PARKING LAYOUT

NORTH	DRAWN BY: ADN	CHECKED BY: SHF	VERIFIED BY: SHF	APPROVED BY: PMD
ORDER NO: F.06-0002	DATE: 20.12.2017	REV: R-1	SCALE: 1:300	STATUS: GFC
	DRAWING NUMBER: NGN-DTD-AR-145146-5301		SHEET NO.	SHEET SIZE: A-2

DSC - NCDDCI

This drawing must not be either based, copied or otherwise reproduced in whole or in part or used for any purpose without the prior written permission of DMRC.

Sec-147

(5)

Extra Sheet

(141)

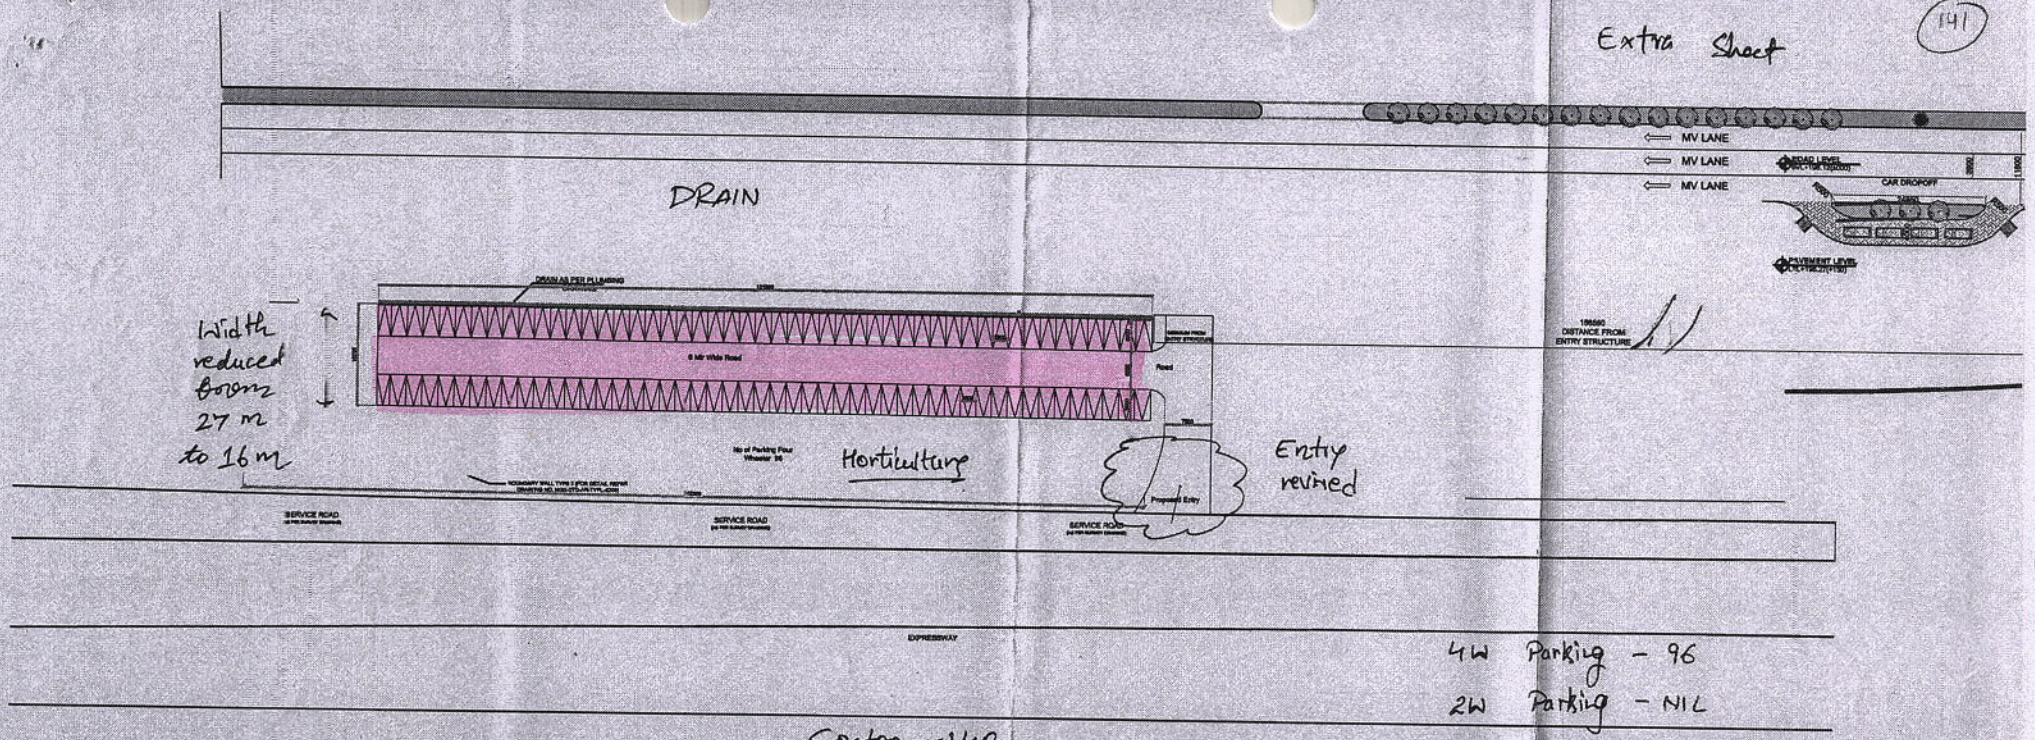

4W Parking - 96

2W Parking - NIL

Sector -148

SEC-148

(4)

140

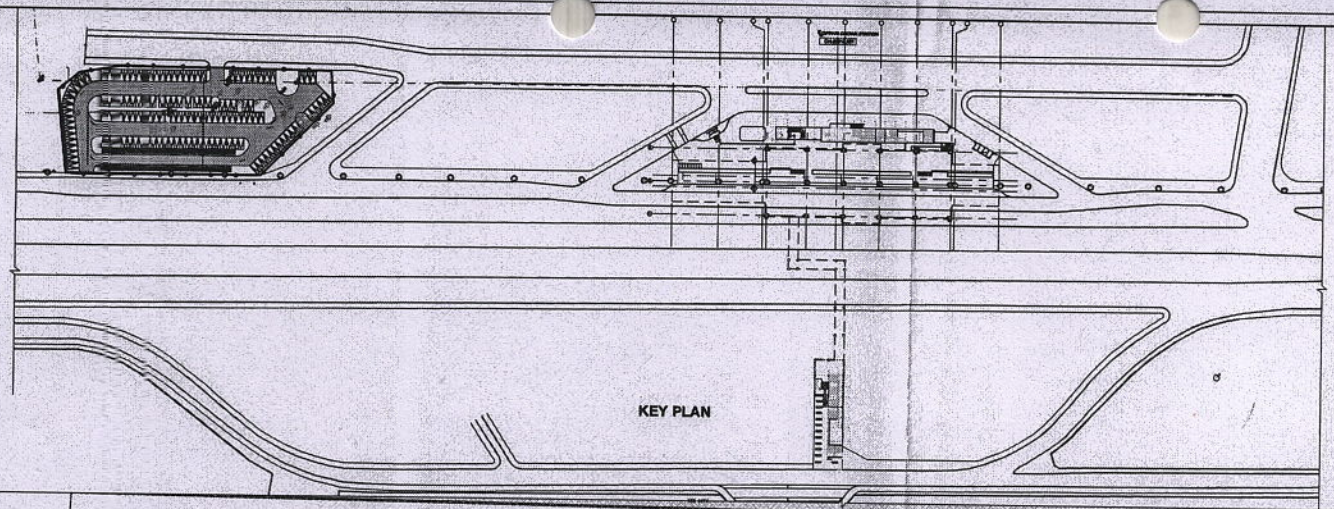

NOTES:

- FOR BOUNDARY WALL DETAIL REFER DRAWING NO. NGN-DTD-AR-TYPL-5200 (TYPE 2)
- FOR GATE DETAIL REFER DRAWING NO. NGN-DTD-AR-TYPL-5201
- FOR TYPICAL PARKING DETAIL REFER DRAWING NO. NGN-DTD-AR-TYPL-5210
- CATCH BASIN AND MAN HOLE LOCATIONS ARE TENTATIVE, FOR DETAIL REFER PLUMBING DRAWINGS.

LEGEND

- LOAD BEARING PAVER BLOCKS (LIGHT)
- LOAD BEARING PAVER BLOCKS (DARK)
- PAVER BLOCKS (LIGHT)
- ROAD
- SHRUBS
- MAINTAINED GREEN
- WILD GREEN
- CYCLE TRACK
- DROP OFF AREA (CONCRETE)
- FLOOR TILES AS PER BOQ
- PAVER BLOCKS (DARK)
- EXISTING ELECTRICAL POLES
- EXISTING TREES
- TREES TO BE CUT/RELOCATED
- PROPOSED TREES
- LAND PLAN
- AREA OF EXTENT OF EXTERNAL DEVELOPMENT

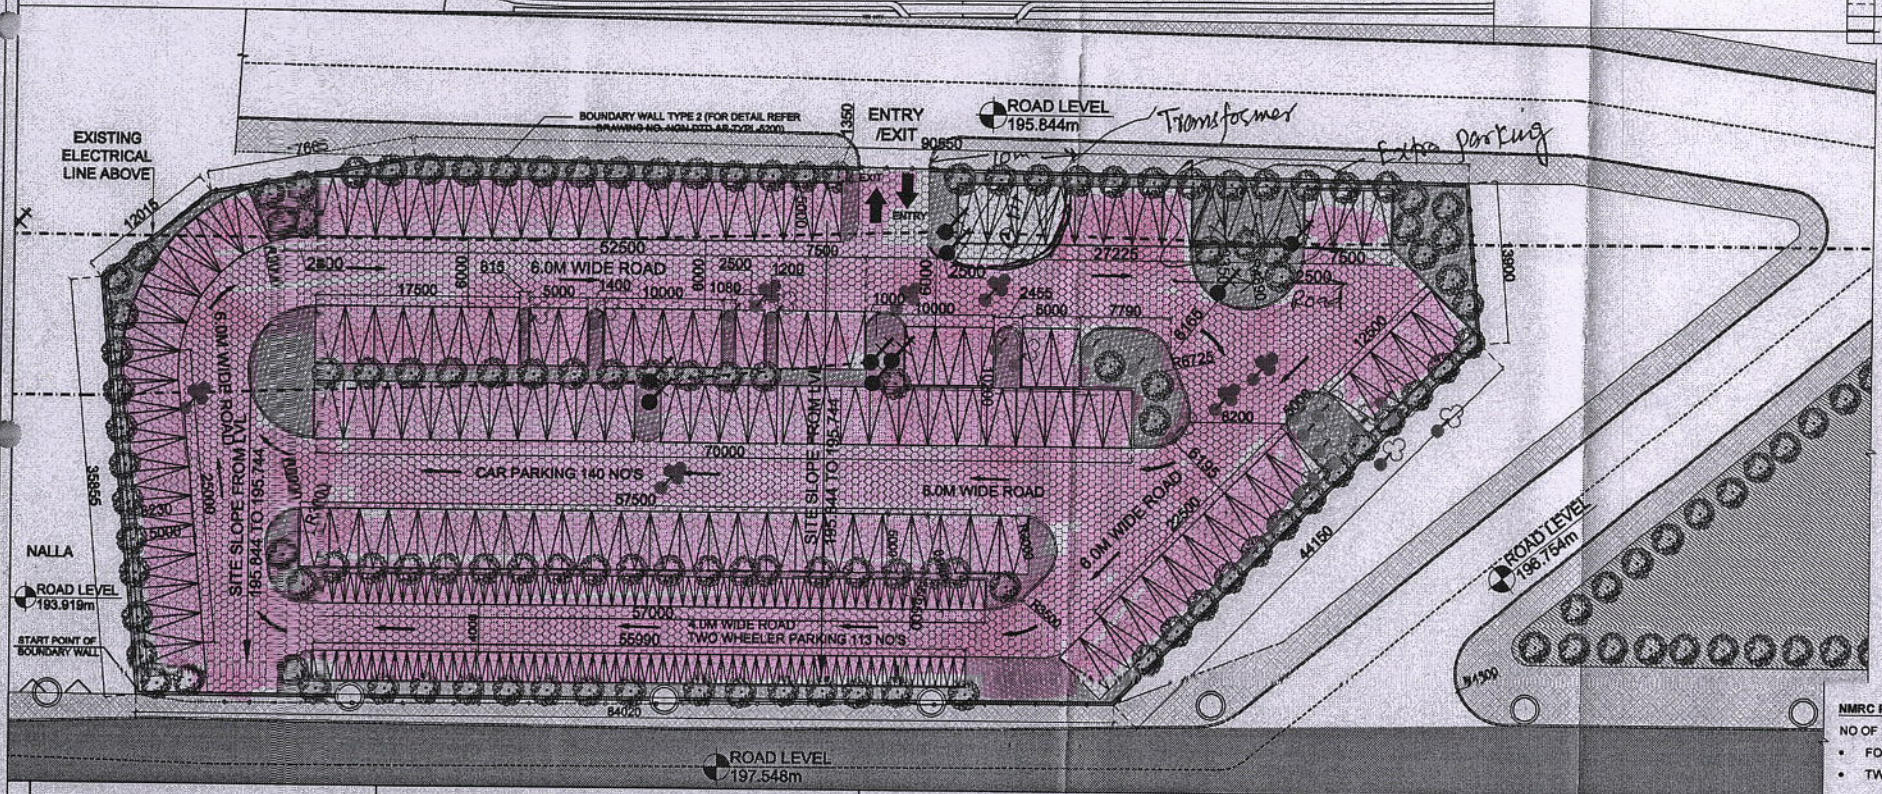

NMRC PARKING DETAIL:

NO OF PARKING:- 128

- FOUR WHEELER: ~~148 NOS~~
- TWO WHEELER : 113 NOS

PARI CHOWK

3

GENERAL NOTES:
1. ALL DIMENSIONS ARE IN MILLIMETER UNLESS MENTIONED.
2. ALL DIMENSIONS ARE TO BE VERIFIED AND NOT SCALED.
3. ANY DISCREPANCY MUST BE BROUGHT TO THE NOTICE OF THE EMPLOYER BEFORE EXECUTION OF WORK (IF ANY).
4. THIS DRAWING MUST BE READ IN CONJUNCTION WITH ALL RELEVANT ARCHITECTURAL, STRUCTURAL, ELECTRICAL & MECHANICAL DRAWINGS.
5. THIS DRAWING MUST BE READ IN CONJUNCTION WITH ALL RELEVANT ARCHITECTURAL DRAWINGS.
6. ALL DIMENSIONS ARE TO BE CHECKED AND VERIFIED ON SITE BEFORE PLACING ANY PARTS OF WORK.

REFERENCE DRAWINGS

REVISION	DESCRIPTION	DRAWING NO.

REVISIONS

REV.	DESCRIPTION	DATE	DRAWN BY	CHECKED BY
R1	STATION PARKING LEVELS ARE REVISED AS PER THE LATEST LEVELS RECEIVED ON 9-3-2018 BY DMRC.	23.03.2018	MANISHA	S. MITTAL
R0	AS PER THE APPROVED EXTERNAL DEVELOPMENT DRAWING NO: NGN-DTD-AR-17PARCH-5001	03.01.2018	A. KHAN	S. MITTAL

APPROVAL OF DMRC OFFICIALS

RA	Dy CA/Arch	CA	AM/Tele	Sr. DGM/Tele	ED/S&T/PJ
AM Elect	DGM/Elec.	CEE	AM/Sig	JGM/S&T-II	ED/S&T/PJ-II
AM AFC	Dy CSTE/AFC	MINE/FIRE	CRE	FGM/SH	

Certified that this document has been designed and checked in accordance with DDC Quality Assurance Plan.

Authorised Signatory for DDC.
NCDDDT Project Manager

Architecture: Design In-charge/ Coordinator
Structure: Design In-charge/ Coordinator
E&M: Design In-charge/ Coordinator

DETAIL DESIGN CONSULTANT :

ayesa
Engineering Information, Imagination.
56, Indo-Asia House, Institutional Area, sector-44
Gurgaon - 122002 (Haryana)

DELHI METRO RAIL CORPORATION LTD.
Metro Bhawan, Fire Brigade Lane, Barakhamba Road, New Delhi-110001

PROJECT: NOIDA - GREATER NOIDA CORRIDOR

STATION: PARI CHOWK

DRAWING TITLE: STATION PARKING LAYOUT

NORTH	DRAWN BY: ADN	CHECKED BY: SHF	VERIFIED BY: SHF	APPROVED BY: PMD
	DATE: 02.01.2018	REV. R-1	SCALE: 1:300	STATUS: GFC
ORDER NO: P56-HED	DRAWING NUMBER: NGN-DTD-AR-17PARCH-5301	SHEET NO.	SHEET SIZE: A-2	DDC / CONSOR.

This drawing not to be either traced, copied or otherwise reproduced in whole or in part or used for any purpose without the prior written permission of DMRC.

ALPHA - 1

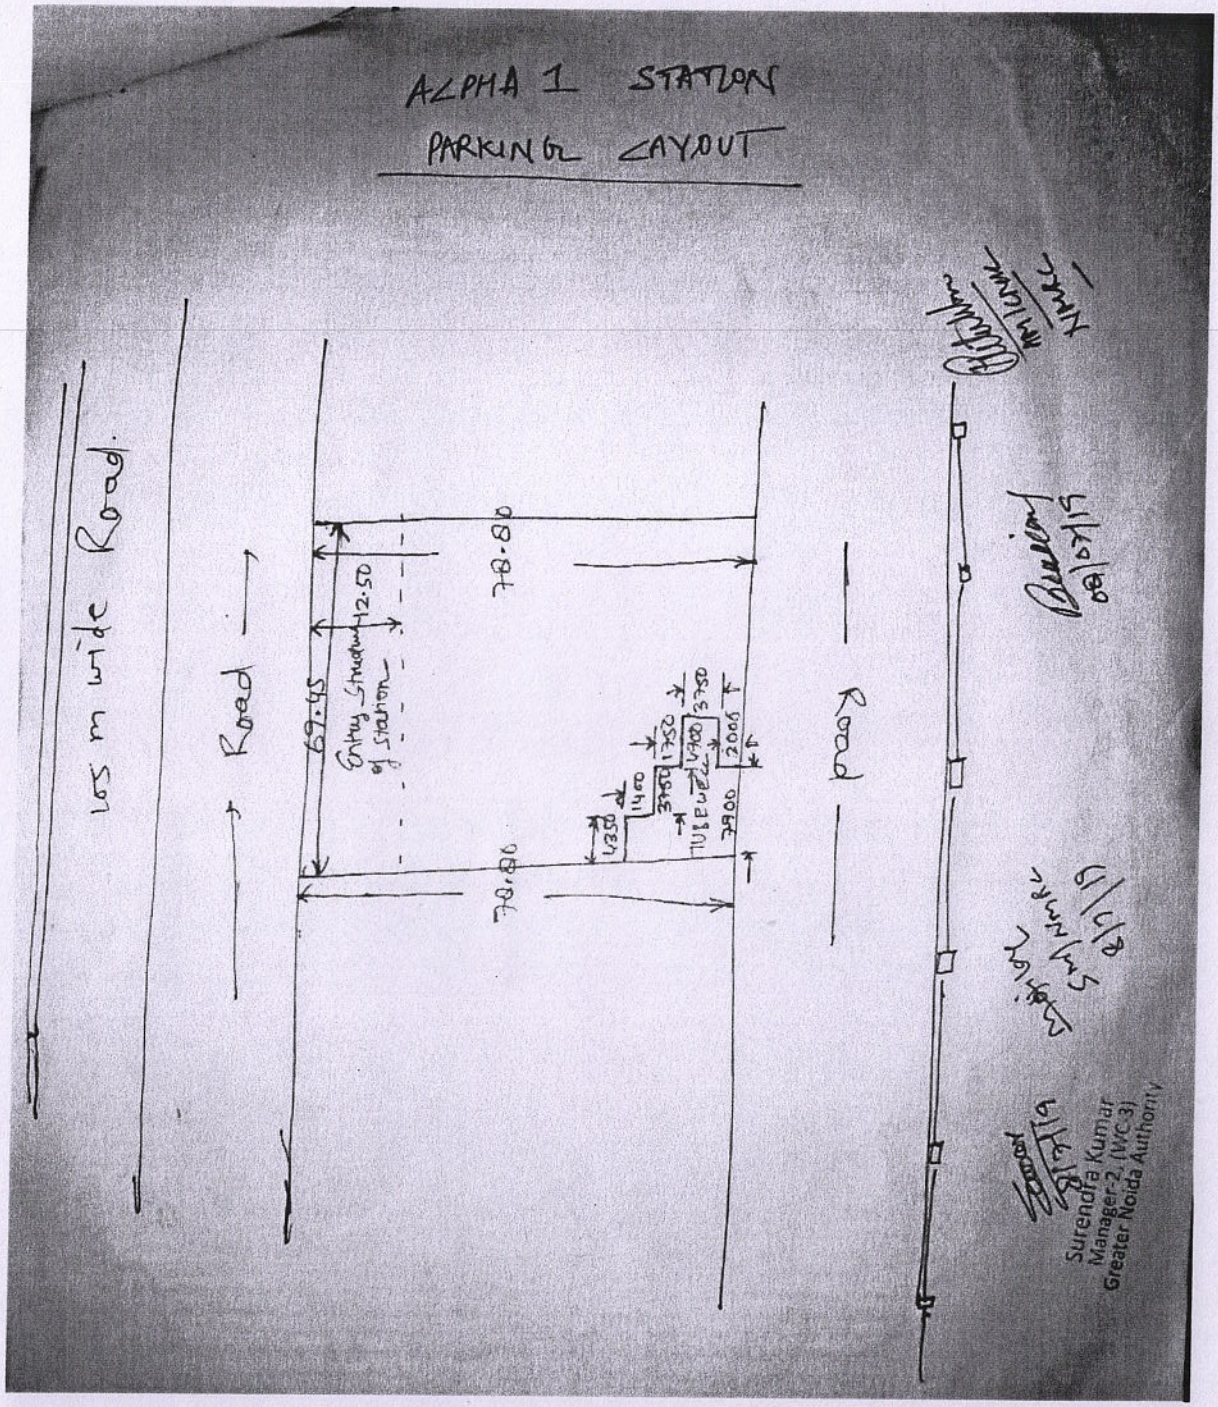

As discussed with NMRC, the available parking area is 4,604.5 sqm (69.45m X 66.3m) with tentatively 128 - 4 wheelers slots and 113 - 2 wheelers slots.

139

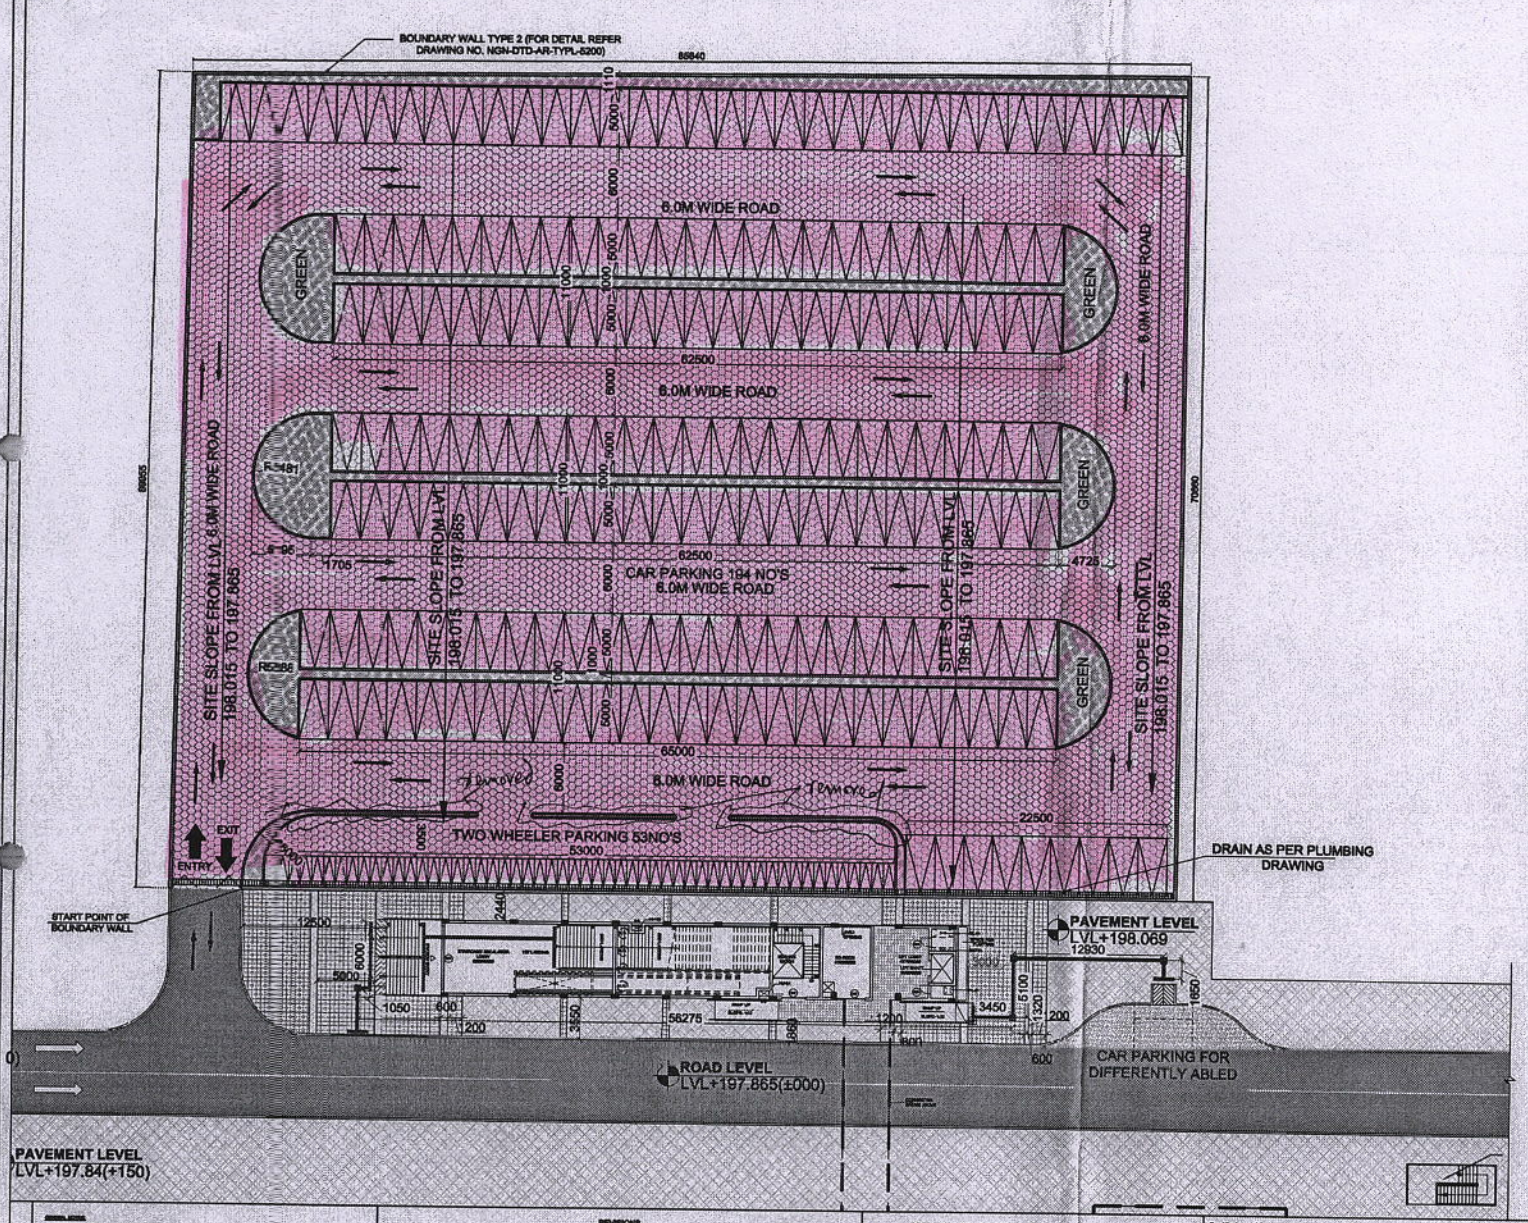

LEGEND

- LOAD BEARING PAVER BLOCKS (LIGHT)
- LOAD BEARING PAVER BLOCKS (DARK)
- PAVER BLOCKS (LIGHT)
- ROAD
- GREEN
- FLOOR TILES AS PER BOQ
- DROP OFF AREA (CONCRETE)
- PAVER BLOCKS (DARK)
- LAND PLAN
- AREA OF EXTENT OF EXTERNAL DEVELOPMENT

NMRC PARKING DETAIL:

NO OF PARKING:-

- FOUR WHEELER:194 NOS
- TWO WHEELER : 53 NOS

DELTA-I

9

REVISIONS				
REV.	DESCRIPTION	DATE	DRAWN BY	CHECKED BY
R1	STATION PARKING LEVELS ARE REVISED AS PER THE LATEST LEVELS RECEIVED ON 5-3-2018 BY DelRC.	22.03.2018	MANISHA	S. MITTAL
R0	AS PER THE APPROVED EXTERNAL DEVELOPMENT DRAWING NO. NGN-DTD-AR-19AL02-5001	03.01.2018	A. KHAN	S. MITTAL

REFERENCE DRAWINGS		
REVISION	DESCRIPTION	DRAWING NO.

APPROVAL OF DMRC OFFICIALS

RA	Dy CM/Arch	CA	AM/Tele	Sr. DGM/Tele	ED/S&T/P-I
AM/ Elect	DGM/Elec.	CEE	AM/Mig	JGM/S&T/II	ED/S&T/P-II
AM/ AFC	Dy CE/S&AFC	MNG/R/RE	CRE	PO/HQ/R	

Certified that this document has been designed and checked in accordance with DDC Quality Assurance Plan.

Authorised Signatory for DDC. NCDD01 Project Manager

Architecture: Design In-charge/ Coordinator | Structure: Design In-charge/ Coordinator | E&M: Design In-charge/ Coordinator

DETAIL DESIGN CONSULTANT :

ayesa Engineering. Information. Imagination.
56, Indo-Asia House, Institutional Area, sector-44
Gurgaon - 122002 (Haryana)

DELHI METRO RAIL CORPORATION LTD.
Metro Bhawan, Fire Brigade Lane, Barakhamba Road, New Delhi-110001

PROJECT: NOIDA - GREATER NOIDA CORRIDOR

STATION: ALPHA 2

DRAWING TITLE: STATION PARKING LAYOUT

SCALE:	DRAWN BY: ADN	CHECKED BY: SHF	VERIFIED BY: SHF	APPROVED BY: PMD
	DATE: 29.11.2017	REV: R-1	SCALE: 1:300	STATUS: GFC
ORDER NO: P94-0002	DRAWING NUMBER: NGN-DTD-AR-19AL02-5301		SHEET NO.	SHEET SIZE: A-2

DDC-NCDD01

This drawing must not be other based, copied or otherwise reproduced in whole or in part or used for any purpose without the prior written permission of DMRC.